


SEE NOTE
ON
SHEET 480

FILE NAME = \$FILE\$
DATE/TIME = \$DATE\$
USER = \$NTUSER\$

DATUM	
VERTICAL	NAVD 88
HORIZONTAL	NAD 83 (1992)

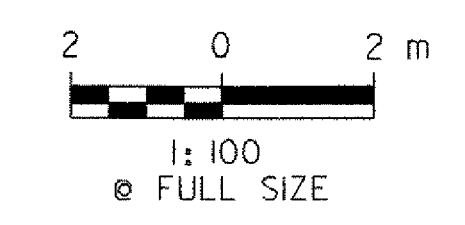

VERMONT AGENCY OF TRANSPORTATION				
	PROJECT NAME:	BENNINGTON		
	PROJECT NUMBER:	AC NH 019-1(53)		
	FILE NAME:	ZD048XSC.DGN	PLOT DATE:	\$DATE\$
	PROJECT LEADER:	D.E.G.	DRAWN BY:	J.S.P.
DESIGNED BY:	J.S.P.	CHECKED BY:	D.E.G.	
CROSS SECTIONS XSC-32		SHEET 511	OF 577	