


HR2+380  
HAUL ROAD A

CUT (HAUL ROAD): 0  
FILL (HAUL ROAD): 4

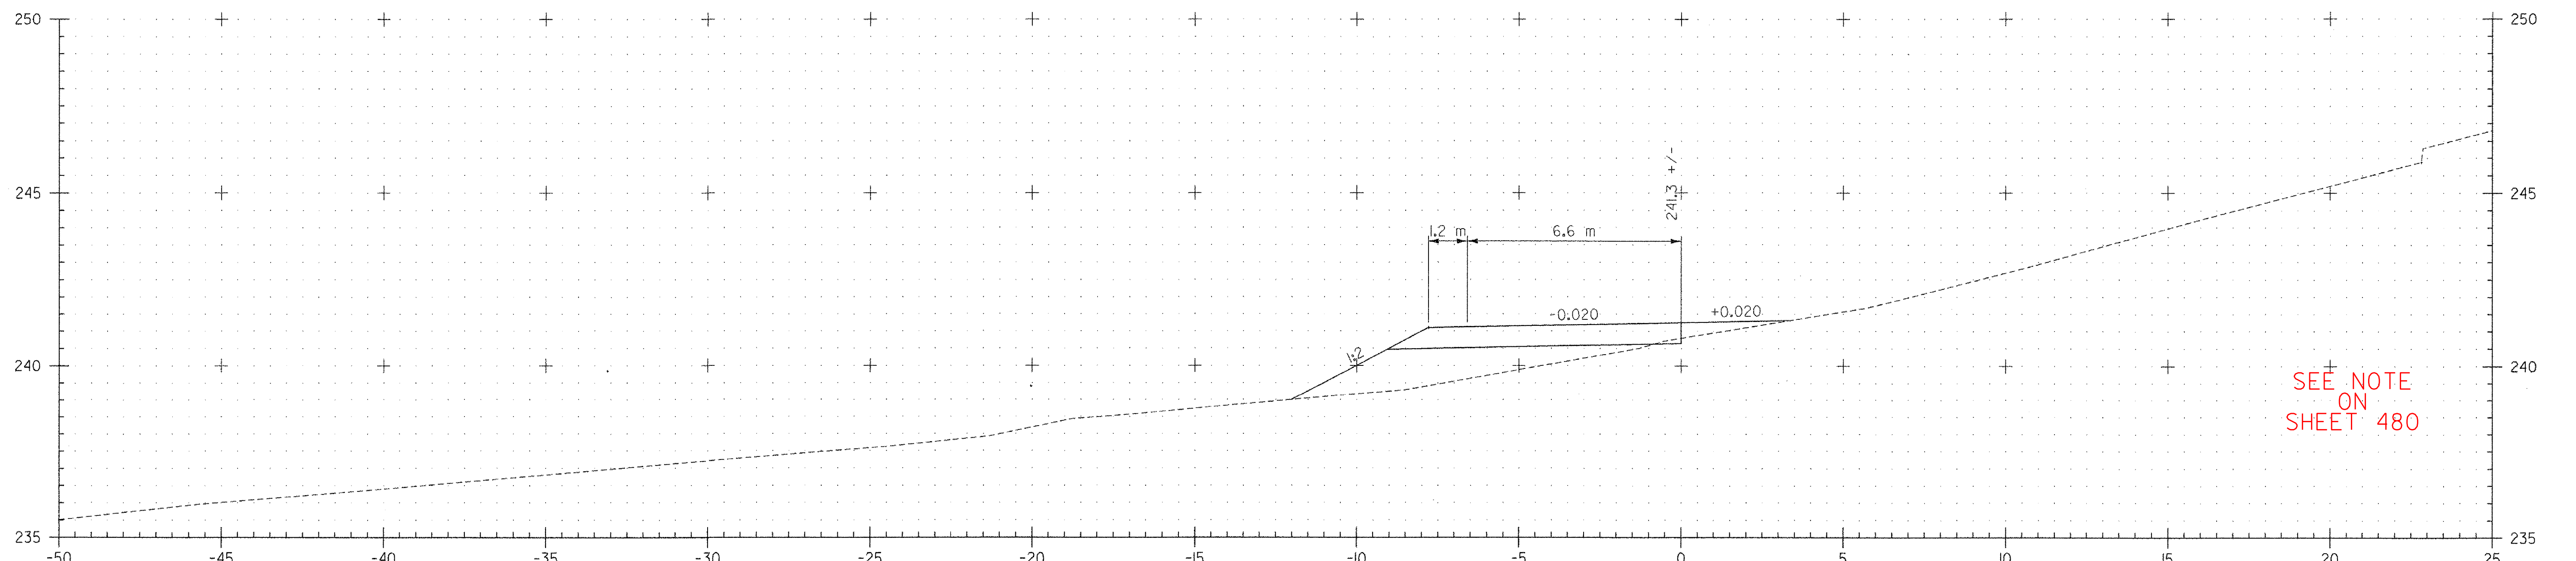


HR2+360  
HAUL ROAD A

CUT (HAUL ROAD): 0  
FILL (HAUL ROAD): 8

SEE NOTE  
ON  
SHEET 480

FILE NAME = \$FILE\$  
DATE/TIME = \$DATE\$  
USER = \$NTUSER\$

DATUM	
VERTICAL	NAVD 88
HORIZONTAL	NAD 83 (1992)

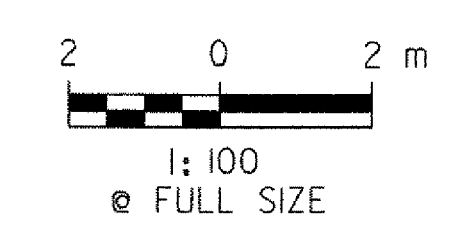

<b>VERMONT AGENCY OF TRANSPORTATION</b>	
 CLOUGH HARBOUR & ASSOCIATES LLP 111 Winners Circle, PO Box 5269, Albany, NY 12205 www.cloughharbour.com	PROJECT NAME: BENNINGTON PROJECT NUMBER: AC NH 019-(153)
	FILE NAME: ZD048XSC.DGN PROJECT LEADER: D.E.G. DESIGNED BY: J.S.P.
<b>CROSS SECTIONS XSC-34</b>	