


FILE NAME = \$FILE\$  
 DATE/TIME = \$DATE\$  
 USER = \$NTUSER\$

DATUM	
VERTICAL	NAVD 88
HORIZONTAL	NAD 83 (1992)



**VERMONT AGENCY OF TRANSPORTATION**

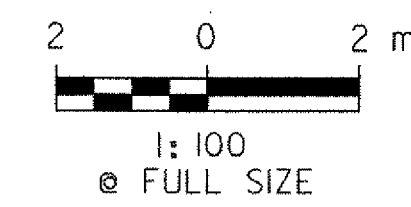

PROJECT NAME:	BENNINGTON	PLOT DATE:	\$DATE\$
PROJECT NUMBER:	AC NH 019-1(53)	DRAWN BY:	J.S.P.
FILE NAME:	ZD048XSC.DGN	CHECKED BY:	D.E.G.
PROJECT LEADER:	D.E.G.	CROSS SECTIONS	XSC-37
DESIGNED BY:	J.S.P.	SHEET	516 OF 577