


FILE NAME = \$FILE\$
DATE/TIME = \$DATE\$ \$TIME\$
USER = \$USER\$

| | |
|------------|---------------|
| DATUM | |
| VERTICAL | NAVD 88 |
| HORIZONTAL | NAD 83 (1992) |



VERMONT AGENCY OF TRANSPORTATION

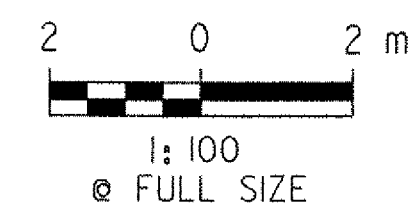

PROJECT NAME: BENNINGTON
PROJECT NUMBER: AC NH 019-1(53)

FILE NAME: ZD048XSC.DGN
PROJECT LEADER: D.E.G.
DESIGNED BY: J.S.P.
CROSS SECTIONS XSC-40

PLOT DATE: \$DATE\$
DRAWN BY: J.S.P.
CHECKED BY: D.E.G.
SHEET 519 OF 577