


SEE NOTE ON SHEET 480

FILE NAME = U:\9819\mstn\03\Clough\Stage One Sites\zd048xsc.f.dgn  
 DATE/TIME = 5/18/2007  
 USER = 1459

DATUM	
VERTICAL	NAVD 88
HORIZONTAL	NAD 83 (1992)

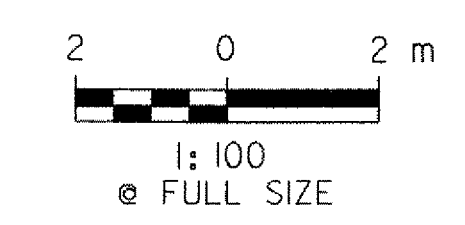

<b>VERMONT AGENCY OF TRANSPORTATION</b>	
 <small>CLOUGH HARBOUR &amp; ASSOCIATES LLP          11 Winners Circle, PO Box 5268, Albany, NY 12205          www.cloughharbour.com</small>	PROJECT NAME: BENNINGTON
	PROJECT NUMBER: AC NH 019-1(53)
	FILE NAME: ZD048XSC.DGN
	PROJECT LEADER: D.E.G.
DESIGNED BY: J.S.P.	PLOT DATE: 5/18/2007
<b>CROSS SECTIONS XSC-49</b>	DRAWN BY: J.S.P.
	CHECKED BY: D.E.G.
	SHEET 528 OF 577