


SEE NOTE
ON
SHEET 480

FILE NAME = U:\9819\mstrn\03\clough\Stage One Sites\zd048xsc.f.dgn
DATE/TIME = 5/18/2007
USER = 1459

DATUM	
VERTICAL	NAVD 88
HORIZONTAL	NAD 83 (1992)

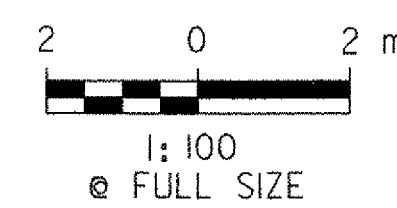

VERMONT AGENCY OF TRANSPORTATION



PROJECT NAME: BENNINGTON
PROJECT NUMBER: AC NH 019-(K53)

FILE NAME: ZD048XSC.DGN
PROJECT LEADER: D.E.G.
DESIGNED BY: J.S.P.
CROSS SECTIONS XSC-51

PLOT DATE: 5/18/2007
DRAWN BY: J.S.P.
CHECKED BY: D.E.G.
SHEET 530 OF 577