


SEE NOTE
ON
SHEET 480

FILE NAME = U:\9819\mstrn\03\clough\Stage One Sites\zd048xsc.f.dgn
DATE/TIME = 5/18/2007
USER = 1459

DATUM	
VERTICAL	NAVD 88
HORIZONTAL	NAD 83 (1992)

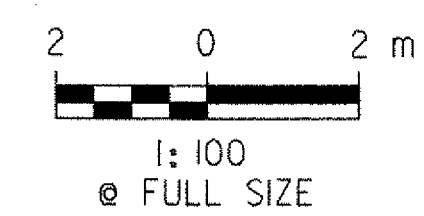

VERMONT AGENCY OF TRANSPORTATION



PROJECT NAME:	BENNINGTON	FILE NAME:	ZD048XSC.DGN	PLOT DATE:	5/18/2007
PROJECT NUMBER:	AC NH 019-(153)	PROJECT LEADER:	D.E.G.	DRAWN BY:	J.S.P.
		DESIGNED BY:	J.S.P.	CHECKED BY:	D.E.G.
		CROSS SECTIONS XSC-54		SHEET 533	OF 577