


SEE NOTE
ON
SHEET 480

FILE NAME = U:\9819\mstrn\03\c\lough\Stage One Sites\zd048xsc.f.dgn
DATE/TIME = 5/18/2007
USER = 1459

DATUM	
VERTICAL	NAVD 88
HORIZONTAL	NAD 83 (1992)

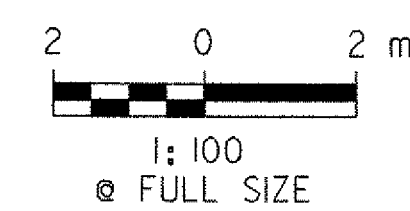

VERMONT AGENCY OF TRANSPORTATION			
 CHA <small>CLOUGH HARBOUR & ASSOCIATES LLP</small> <small>111 Winners Circle, PO Box 9288, Albany, NY 12205</small> <small>www.cloughharbour.com</small>	PROJECT NAME: BENNINGTON		FILE NAME: ZD048XSC.DGN
	PROJECT NUMBER: AC NH 019-1(53)		PROJECT LEADER: D.E.G.
			DESIGNED BY: J.S.P.
			CROSS SECTIONS XSC-56
		PLOT DATE: 5/18/2007	DRAWN BY: J.S.P.
		CHECKED BY: D.E.G.	SHEET 535 OF 577