


SEE NOTE
ON
SHEET 480

FILE NAME = U:\9819\mstn\03\clough\Stage One Sites\zd048xsc-f.dgn
DATE/TIME = 5/18/2007
USER = 1459

DATUM	
VERTICAL	NAVD 88
HORIZONTAL	NAD 83 (1992)

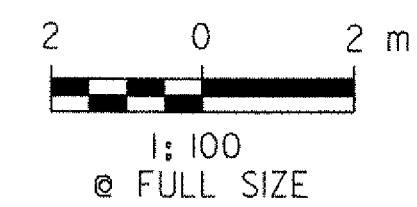

VERMONT AGENCY OF TRANSPORTATION



PROJECT NAME:	BENNINGTON	FILE NAME:	ZD048XSC.DGN	PLOT DATE:	5/18/2007
PROJECT NUMBER:	AC NH 019-1(53)	PROJECT LEADER:	D.E.G.	DRAWN BY:	J.S.P.
		DESIGNED BY:	J.S.P.	CHECKED BY:	D.E.G.
CROSS SECTIONS XSC-57				SHEET 536	OF 577