


SEE NOTE  
ON  
SHEET 480

FILE NAME = U:\9819\mstr\03\c\ough\stage One Sites\zd048xsc.f.dgn  
DATE/TIME = 5/18/2007  
USER = 1459

DATUM	
VERTICAL	NAVD 88
HORIZONTAL	NAD 83 (1992)

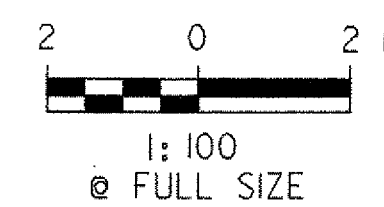

VERMONT AGENCY OF TRANSPORTATION



PROJECT NAME: BENNINGTON  
PROJECT NUMBER: AC NH 019-(153)

FILE NAME: ZD048XSC.DGN  
PROJECT LEADER: D.E.G.  
DESIGNED BY: J.S.P.

**CROSS SECTIONS XSC-58**

PLOT DATE: 5/18/2007  
DRAWN BY: J.S.P.  
CHECKED BY: D.E.G.  
SHEET 537 OF 577