


SEE NOTE
ON
SHEET 480

FILE NAME = U:\9819\mstn\03\Cough\Stage One Sites\zd048xsc.f.dgn
DATE/TIME = 5/18/2007
USER = 1459

DATUM	
VERTICAL	NAVD 88
HORIZONTAL	NAD 83 (1992)

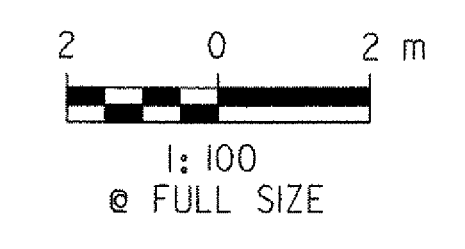

VERMONT AGENCY OF TRANSPORTATION	
 CLOUGH HARBOUR & ASSOCIATES LLP 111 Warren Circle, PO Box 5209, Albany, NY 12205 www.cloughharbour.com	PROJECT NAME: BENNINGTON PROJECT NUMBER: AC NH 019-(153)
	FILE NAME: ZD048XSC.DGN PROJECT LEADER: D.E.G. DESIGNED BY: J.S.P. CROSS SECTIONS XSC-62