



CUT (STAGE ONE SITE): 0
 FILL (STAGE ONE SITE): 306
 CUT (HAUL ROAD): 0
 FILL (HAUL ROAD): 11

FILE NAME = U:\9819\mstn\03\clough\Stage One Sites\zd048xsc.f.dgn
 DATE/TIME = 5/18/2007
 USER = 1459

DATUM	
VERTICAL	NAVD 88
HORIZONTAL	NAD 83 (1992)

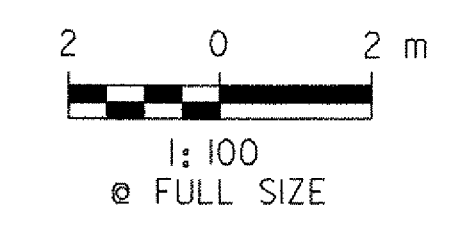

VERMONT AGENCY OF TRANSPORTATION	
 CLOUGH HARBOUR & ASSOCIATES LLP <small>11 Winners Circle, PO Box 9268, Albany, NY 12205 www.cloughharbour.com</small>	PROJECT NAME: BENNINGTON PROJECT NUMBER: AC NH 019-(153)
	FILE NAME: ZD048XSC.DGN PROJECT LEADER: D.E.G. DESIGNED BY: J.S.P. CROSS SECTIONS XSC-66