


SEE NOTE  
ON  
SHEET 480

FILE NAME = U:\9819\mstn\03\clough\Stage One Sites\zd048xsc.f.dgn  
DATE / TIME = 5/18/2007  
USER = 1459

DATUM	
VERTICAL	NAVD 88
HORIZONTAL	NAD 83 (1992)

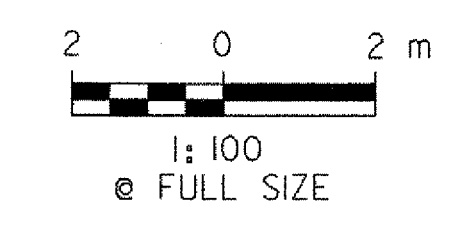

<b>VERMONT AGENCY OF TRANSPORTATION</b>	
<p><b>CHA</b> CLOUGH HARBOUR &amp; ASSOCIATES LLP 11 Winners Circle, PO Box 9298, Albany, NY 12205 www.cloughharbour.com</p>	PROJECT NAME: BENNINGTON
	PROJECT NUMBER: AC NH 019-1(53)
	FILE NAME: ZD048XSC.DGN
PROJECT LEADER: D.E.G.	PLOT DATE: 5/18/2007
DESIGNED BY: J.S.P.	DRAWN BY: J.S.P.
<b>CROSS SECTIONS XSC-68</b>	CHECKED BY: D.E.G.
	SHEET 547 OF 577