


HR3+280  
HAUL ROAD A

CUT (STAGE ONE SITE):	0	CUT (HAUL ROAD):	0
FILL (STAGE ONE SITE):	10	FILL (HAUL ROAD):	0

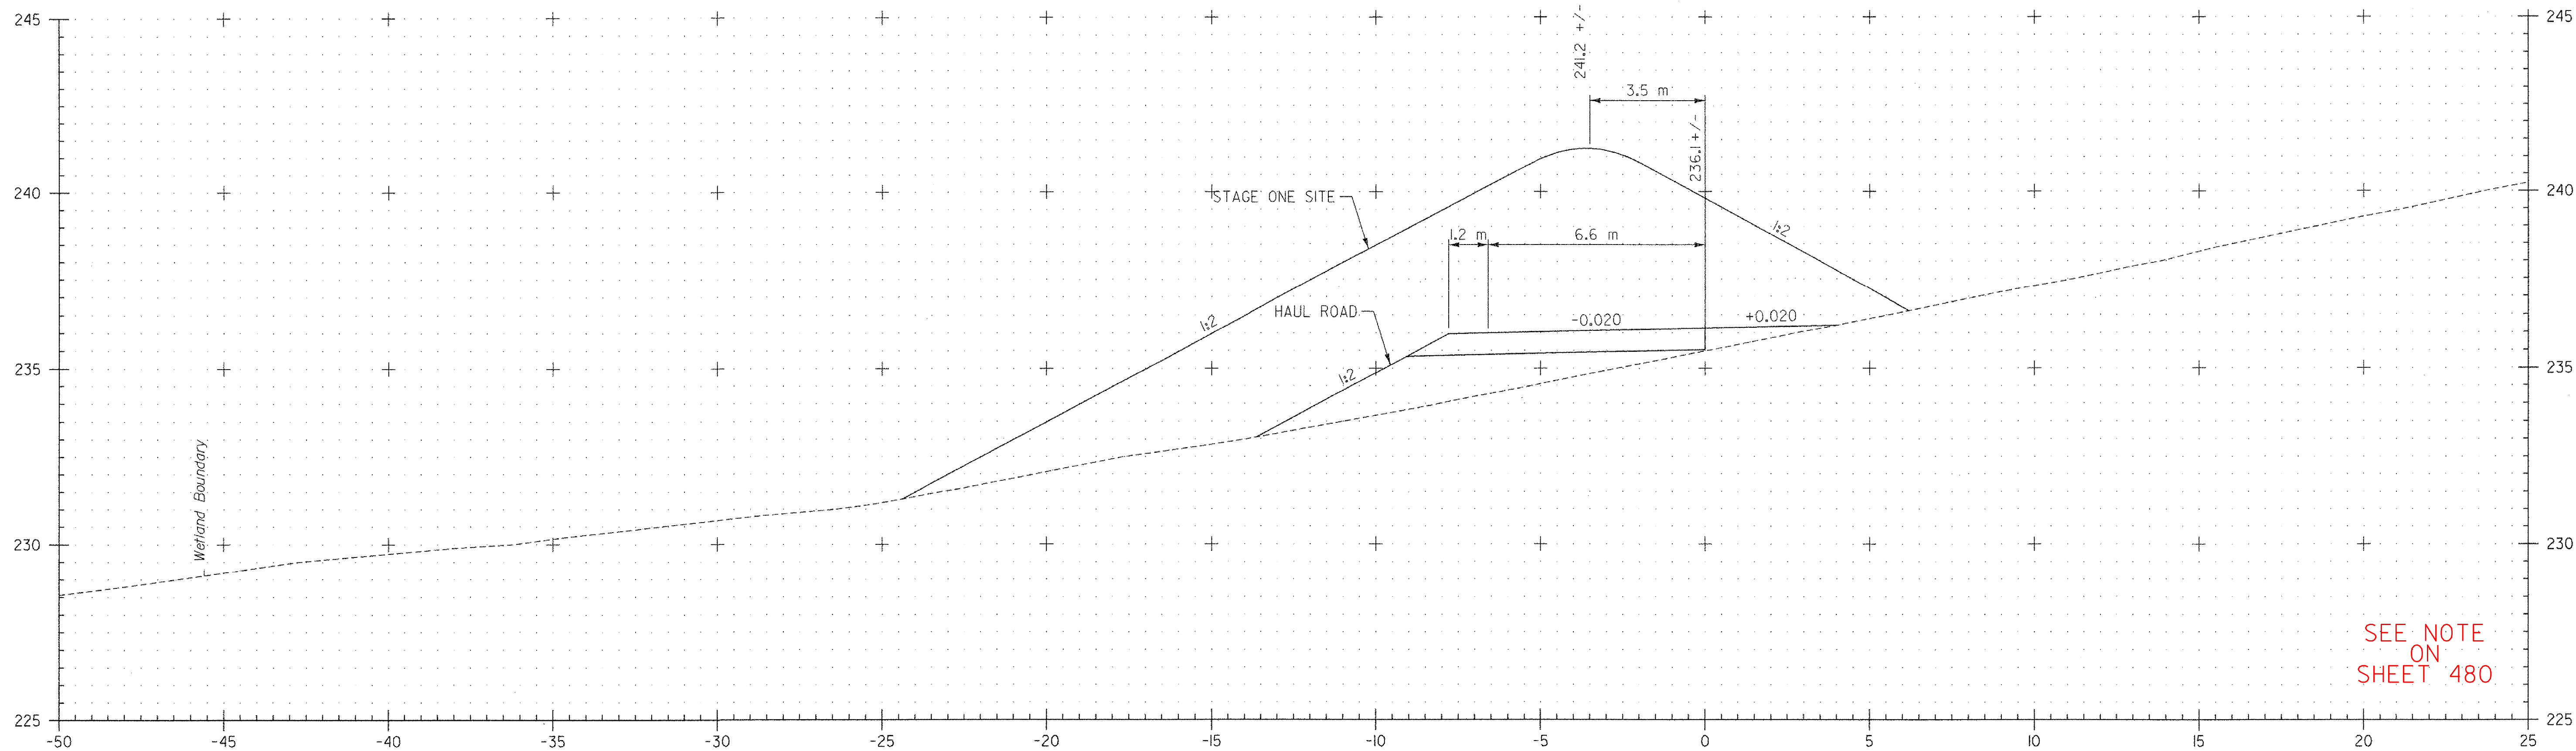

HR3+260  
HAUL ROAD A

CUT (STAGE ONE SITE):	0	CUT (HAUL ROAD):	0
FILL (STAGE ONE SITE):	88	FILL (HAUL ROAD):	12

SEE NOTE  
ON  
SHEET 480

FILE NAME = U:\9819\mstrn\03\clough\Stage One Sites\zd048xsc.f.dgn  
DATE/TIME = 5/18/2007  
USER = 1459

DATUM  
VERTICAL NAVD 88  
HORIZONTAL NAD 83 (1992)

2 0 2 m  
1:100  
@ FULL SIZE

VERMONT AGENCY OF TRANSPORTATION



PROJECT NAME: BENNINGTON  
PROJECT NUMBER: AC NH 019-(53)

FILE NAME: ZD048XSC.DGN  
PROJECT LEADER: D.E.G.  
DESIGNED BY: J.S.P.

PLOT DATE: 5/18/2007  
DRAWN BY: J.S.P.  
CHECKED BY: D.E.G.  
SHEET 549 OF 577

CROSS SECTIONS XSC-70