


SEE NOTE
ON
SHEET 480

FILE NAME = U:\9819\mstun\03\c\lough\Stage One Sites\zd048xsc.f.dgn
DATE/TIME = 5/18/2007
USER = J459

DATUM	
VERTICAL	NAVD 88
HORIZONTAL	NAD 83 (1992)

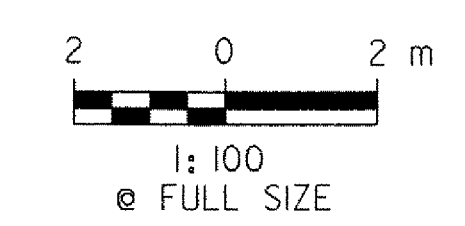

VERMONT AGENCY OF TRANSPORTATION	
 CHA <small>CLOUGH HARBOUR & ASSOCIATES LLP 11 Winners Circle, PO Box 5260, Albany, NY 12205 www.clogharbour.com</small>	PROJECT NAME: BENNINGTON
	PROJECT NUMBER: AC NH 019-(53)
FILE NAME: ZD048XSC.DGN	PLOT DATE: 5/18/2007
PROJECT LEADER: D.E.G.	DRAWN BY: J.S.P.
DESIGNED BY: J.S.P.	CHECKED BY: D.E.G.
CROSS SECTIONS XSC-72	SHEET 551 OF 577