


SEE NOTE  
ON  
SHEET 480

FILE NAME = U:\9819\mstn\03\c\ough\Stage One Sites\zd048xsc.f.dgn  
DATE/TIME = 5/18/2007  
USER = 1459

DATUM	
VERTICAL	NAVD 88
HORIZONTAL	NAD 83 (1992)

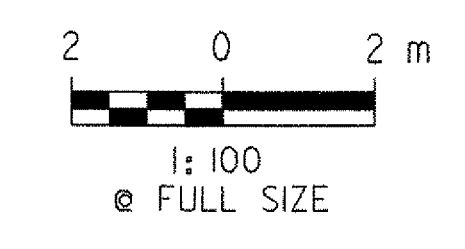

<b>VERMONT AGENCY OF TRANSPORTATION</b>	
	PROJECT NAME: BENNINGTON
	PROJECT NUMBER: AC NH 019-1(53)
	FILE NAME: ZD048XSC.DGN
	<b>CROSS SECTIONS XSC-73</b>
	PLOT DATE: 5/18/2007
	DRAWN BY: J.S.P.
	CHECKED BY: D.E.G.
	SHEET 552 OF 577