


HRBI+400  
HAUL ROAD B

CUT (STAGE ONE SITE): 0  
FILL (STAGE ONE SITE): 78  
CUT (HAUL ROAD): 0  
FILL (HAUL ROAD): 3

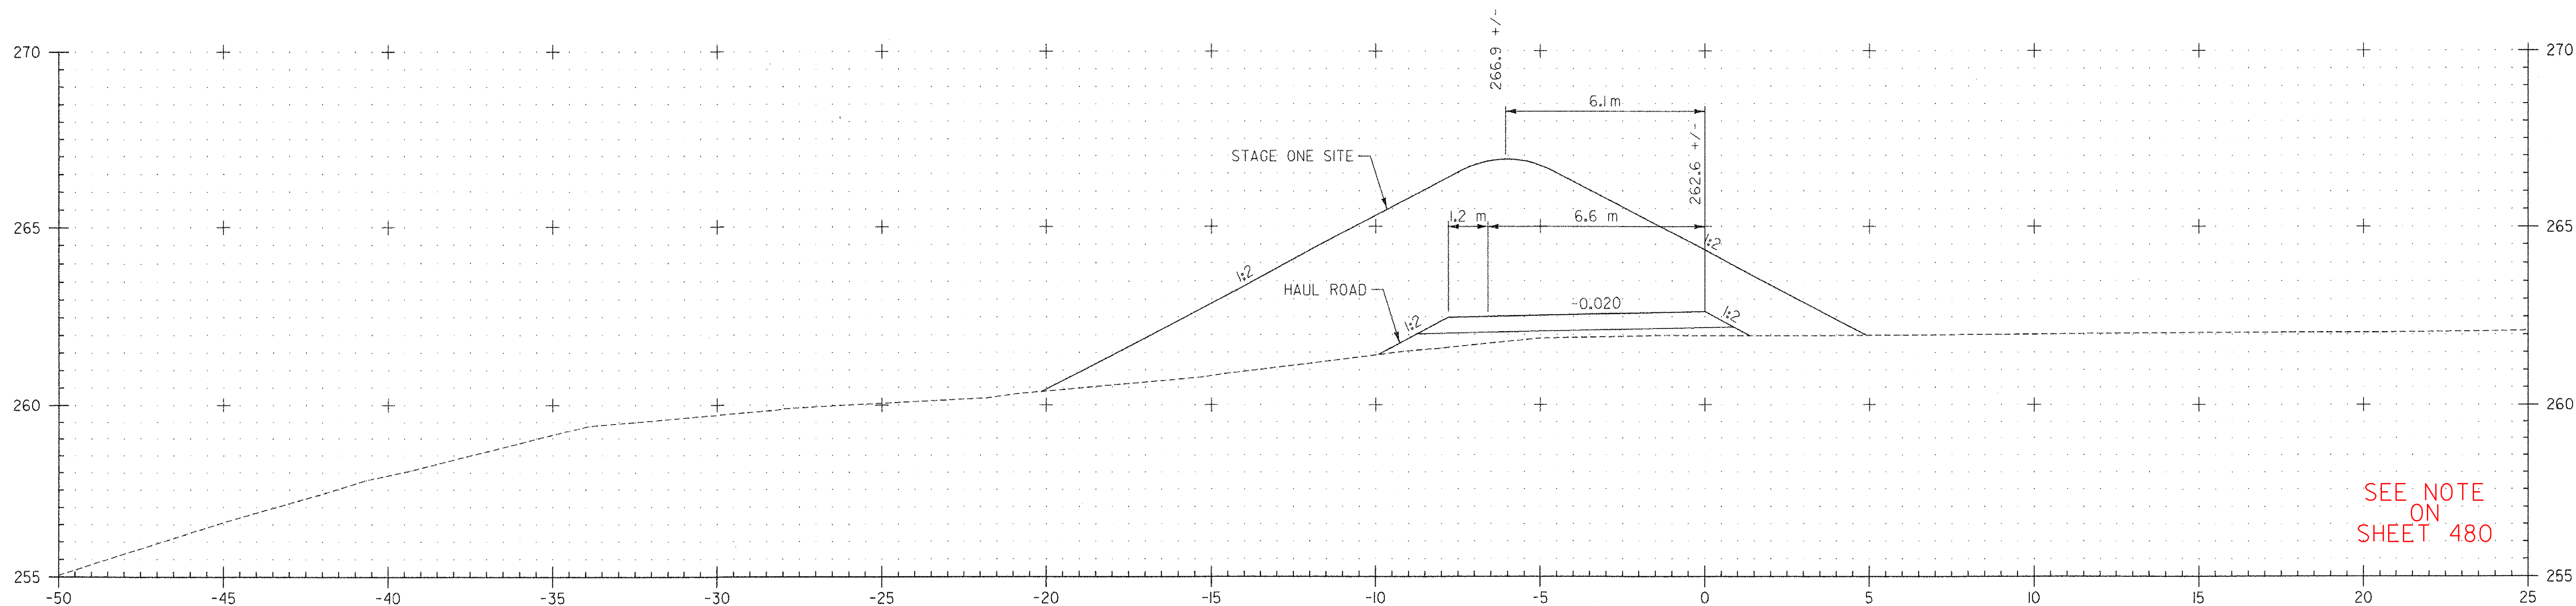

HRBI+380  
HAUL ROAD B

CUT (STAGE ONE SITE): 0  
FILL (STAGE ONE SITE): 62  
CUT (HAUL ROAD): 0  
FILL (HAUL ROAD): 3

SEE NOTE  
ON  
SHEET 480

FILE NAME = I:\9819\mstr\03\clough\stage One Sites\zd048xsc.f.dgn  
DATE/TIME = 5/18/2007  
USER = 1459

DATUM  
VERTICAL NAVD 88  
HORIZONTAL NAD 83 (1992)

2 0 2 m  
1:100  
@ FULL SIZE

VERMONT AGENCY OF TRANSPORTATION



PROJECT NAME: BENNINGTON  
PROJECT NUMBER: AC NH 019-1(53)

FILE NAME: ZD048XSC.DGN  
PROJECT LEADER: D.E.G.  
DESIGNED BY: J.S.P.  
CROSS SECTIONS XSC-74

PLOT DATE: 5/18/2007  
DRAWN BY: J.S.P.  
CHECKED BY: D.E.G.  
SHEET 553 OF 577