


CUT (STAGE ONE SITE):	0	CUT (HAUL ROAD):	0
FILL (STAGE ONE SITE):	238	FILL (HAUL ROAD):	12

FILE NAME = U:\9819\mstn\03\clough\Stage One Sites\zd048xsc.f.dgn
 DATE/TIME = 5/18/2007
 USER = 1459

DATUM	
VERTICAL	NAVD 88
HORIZONTAL	NAD 83 (1992)

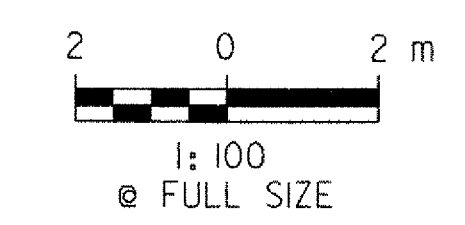

VERMONT AGENCY OF TRANSPORTATION	
 <small>CLOUGH HARBOUR & ASSOCIATES LLP</small> <small>111 Winners Circle, PO Box 5286, Albany, NY 12205</small> <small>www.cloughharbour.com</small>	PROJECT NAME: BENNINGTON
	PROJECT NUMBER: AC NH 019-1(53)
	FILE NAME: ZD048XSC.DGN
	DESIGNED BY: J.S.P.
CROSS SECTIONS XSC-76	
PROJECT LEADER: D.E.G.	PLOT DATE: 5/18/2007
CHECKED BY: D.E.G.	DRAWN BY: J.S.P.
	CHEKED BY: D.E.G.
	SHEET 555 OF 577