


SEE NOTE
ON
SHEET 480

FILE NAME = I:\9819\mstn\03\clough\Stage One Sites\zd048xsc.f.dgn
DATE/TIME = 5/18/2007
USER = J459

DATUM	
VERTICAL	NAVD 88
HORIZONTAL	NAD 83 (1992)

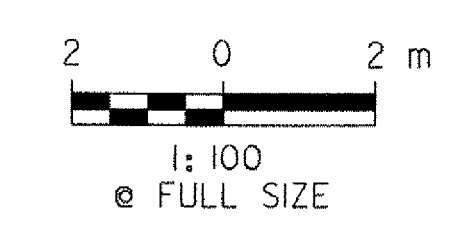

VERMONT AGENCY OF TRANSPORTATION	
<p>CHA CLOUGH HARBOUR & ASSOCIATES LLP 11 Winners Circle, PO Box 5206, Albany, NY 12205 www.cloughharbour.com</p>	PROJECT NAME: BENNINGTON
	PROJECT NUMBER: AC NH 019-(K53)
	FILE NAME: ZD048XSC.DGN
PROJECT LEADER: D.E.G.	PLOT DATE: 5/18/2007
DESIGNED BY: J.S.P.	DRAWN BY: J.S.P.
CROSS SECTIONS XSC-77	CHECKED BY: D.E.G.
	SHEET 556 OF 577