


SEE NOTE ON SHEET 480

FILE NAME = J:\9819\mstn\03\cough\Stage One Sites\zd048xsc.f.dgn
 DATE/TIME = 5/18/2007
 USER = 1459

DATUM
 VERTICAL NAVD 88
 HORIZONTAL NAD 83 (1992)

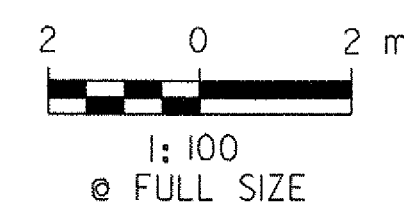

VERMONT AGENCY OF TRANSPORTATION



PROJECT NAME: BENNINGTON
 PROJECT NUMBER: AC NH 019-(153)

FILE NAME: ZD048XSC.DGN
 PROJECT LEADER: D.E.G.
 DESIGNED BY: J.S.P.

PLOT DATE: 5/18/2007
 DRAWN BY: J.S.P.
 CHECKED BY: D.E.G.
 SHEET 557 OF 577

CROSS SECTIONS XSC-78