


CUT: 6  
FILL: 0

FILE NAME = I:\9819\mstrn\03\clough\Stage One States\zd048xsc-f.dgn  
DATE/TIME = 5/18/2007  
USER = 1459

DATUM	
VERTICAL	NAVD 88
HORIZONTAL	NAD 83 (1992)

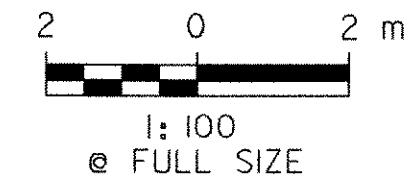

<b>VERMONT AGENCY OF TRANSPORTATION</b>	
<p><b>CHA</b> CLOUGH HARBOUR &amp; ASSOCIATES LLP 11 Winners Circle, PO Box 5289, Albany, NY 12205 www.cloughharbour.com</p>	PROJECT NAME: BENNINGTON
	PROJECT NUMBER: AC NH 019-1(53)
	FILE NAME: ZD048XSC.DGN
	DESIGNED BY: J.S.P.
<b>CROSS SECTIONS XSC-81</b>	PLOT DATE: 5/18/2007 DRAWN BY: J.S.P. CHECKED BY: D.E.G. SHEET 560 OF 577