


FILE NAME = U:\9819\mstrn\03\c\lough\Stage One Sites\zd048xsc.f.dgn
 DATE/TIME = 5/18/2007
 USER = 1459

DATUM	
VERTICAL	NAVD 88
HORIZONTAL	NAD 83 (1992)



VERMONT AGENCY OF TRANSPORTATION

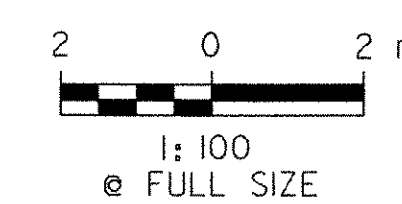

PROJECT NAME: BENNINGTON
 PROJECT NUMBER: AC NH 019-1(53)

FILE NAME: ZD048XSC.DGN
 PROJECT LEADER: D.E.G.
 DESIGNED BY: J.S.P.
CROSS SECTIONS XSC-83

PLOT DATE: 5/18/2007
 DRAWN BY: J.S.P.
 CHECKED BY: D.E.G.
 SHEET 562 OF 577