


CUT: 0  
FILL: 9

FILE NAME = U:\9819\mstrn\03\clough\Stage One Sites\zd048\sc.f.dgn  
DATE/TIME = 5/18/2007  
USER = 1459

DATUM	
VERTICAL	NAVD 88
HORIZONTAL	NAD 83 (1992)

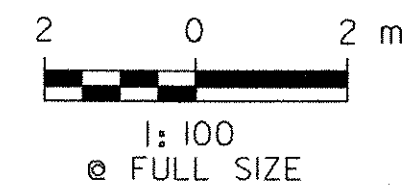

<b>VERMONT AGENCY OF TRANSPORTATION</b>	
<p><b>CHA</b> CLOUGH HARBOUR &amp; ASSOCIATES LLP 111 Winners Circle, PO Box 5069, Albany, NY 12205 www.cloughharbour.com</p>	PROJECT NAME: BENNINGTON
	PROJECT NUMBER: AC NH 019-1(53)
	FILE NAME: ZD048XSC.DGN
	<b>CROSS SECTIONS XSC-85</b>
	PLOT DATE: 5/18/2007
	DRAWN BY: J.S.P.
	CHECKED BY: D.E.G.
	SHEET 564 OF 577