


CUT: 1
FILL: 8

FILE NAME = U:\9819\mstrn\03\c\lough\Stage One Sites\zd048xsc.f.dgn
DATE/TIME = 5/18/2007
USER = 1459

DATUM	
VERTICAL	NAVD 88
HORIZONTAL	NAD 83 (1992)

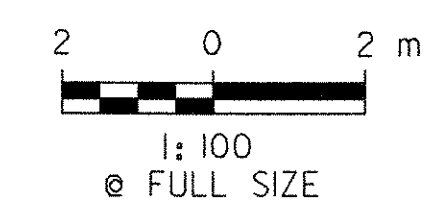

VERMONT AGENCY OF TRANSPORTATION		
<p>CHA CLOUGH HARBOUR & ASSOCIATES LLP 111 Winners Circle, PO Box 5289, Albany, NY 12205 www.cloughharbour.com</p>	PROJECT NAME: BENNINGTON PROJECT NUMBER: AC NH 019-1(53)	
	FILE NAME: ZD048XSC.DGN PROJECT LEADER: D.E.G. DESIGNED BY: J.S.P.	PLOT DATE: 5/18/2007 DRAWN BY: J.S.P. CHECKED BY: D.E.G.
	CROSS SECTIONS XSC-86	
SHEET 565 OF 577		