


FILE NAME = U:\9819\mstn\03\cough\Stage One Sites\zd048xsc.f.dgn  
 DATE/TIME = 5/18/2007  
 USER = 1459

DATUM	
VERTICAL	NAVD 88
HORIZONTAL	NAD 83 (1992)

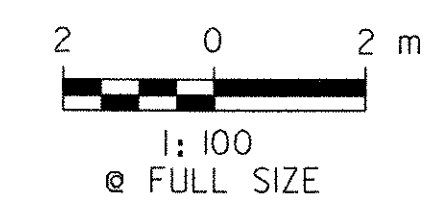

<b>VERMONT AGENCY OF TRANSPORTATION</b>	
 <b>CHA</b> <small>CLOUGH HARBOUR &amp; ASSOCIATES LLP</small> <small>111 Winners Circle, PO Box 5289, Albany, NY 12205</small> <small>www.cloughharbour.com</small>	PROJECT NAME: BENNINGTON PROJECT NUMBER: AC NH 019-1(53)
	FILE NAME: ZD048XSC.DGN PROJECT LEADER: D.E.G. DESIGNED BY: J.S.P. <b>CROSS SECTIONS XSC-90</b>