


FILE NAME = U:\9819\mstn\03\clough\Stage One Sites\zd048xsc.f.dgn
 DATE/TIME = 5/18/2007
 USER = 1459

DATUM	
VERTICAL	NAVD 88
HORIZONTAL	NAD 83 (1992)

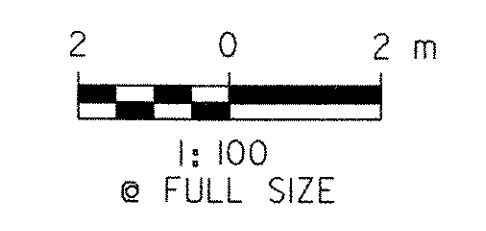

VERMONT AGENCY OF TRANSPORTATION	
 CHA <small>CLOUGH HARBOUR & ASSOCIATES LLP</small> <small>11 Winners Circle, PO Box 526, Albany, NY 12205</small> <small>www.cloughharbour.com</small>	PROJECT NAME: BENNINGTON PROJECT NUMBER: AC NH 019-1(53)
	FILE NAME: ZD048XSC.DGN PROJECT LEADER: D.E.G. DESIGNED BY: J.S.P. CROSS SECTIONS XSC-91