


FILE NAME = U:\9819\mstn\03\clough\Stage One Sites\zd048xsc.f.dgn
 DATE/TIME = 5/18/2007
 USER = 1459

DATUM	
VERTICAL	NAVD 88
HORIZONTAL	NAD 83 (1992)



VERMONT AGENCY OF TRANSPORTATION

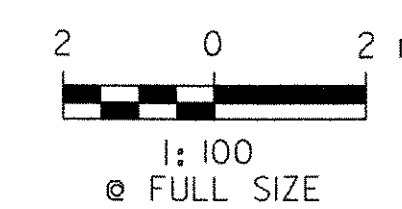

PROJECT NAME:	BENNINGTON	PLOT DATE:	5/18/2007
PROJECT NUMBER:	AC NH 019-I(53)	DRAWN BY:	J.S.P.
FILE NAME:	ZD048XSC.DGN	CHECKED BY:	D.E.G.
PROJECT LEADER:	D.E.G.		
DESIGNED BY:	J.S.P.		
CROSS SECTIONS XSC-93		SHEET 572	OF 577