


FILE NAME = U:\9819\mstrn\03\clough\Stage One Sites\zd048xsc.f.dgn  
DATE/TIME = 5/18/2007  
USER = 1459

DATUM	
VERTICAL	NAVD 88
HORIZONTAL	NAD 83 (1992)

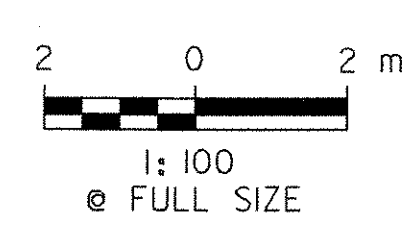

<b>VERMONT AGENCY OF TRANSPORTATION</b>	
 <small>CLOUGH HARBOUR &amp; ASSOCIATES LLP 111 Winners Circle, PO Box 6266, Albany, NY 12206 www.cloughharbour.com</small>	PROJECT NAME: BENNINGTON
	PROJECT NUMBER: AC NH 019-I(53)
	FILE NAME: ZD048XSC.DGN
	DESIGNED BY: J.S.P.
<b>CROSS SECTIONS XSC-96</b>	
	PLOT DATE: 5/18/2007 DRAWN BY: J.S.P. CHECKED BY: D.E.G. SHEET 575 OF 577