


METRIC
 Scale = 0.012000 of full size.
 SHIPMENT 01
 PK#ENG 5002817 PRJ 5002818 SHIP#RECT 5002819
 BY: Mckendal
 PLOTTED: 11/30/2007 12:43:32 PM
 60

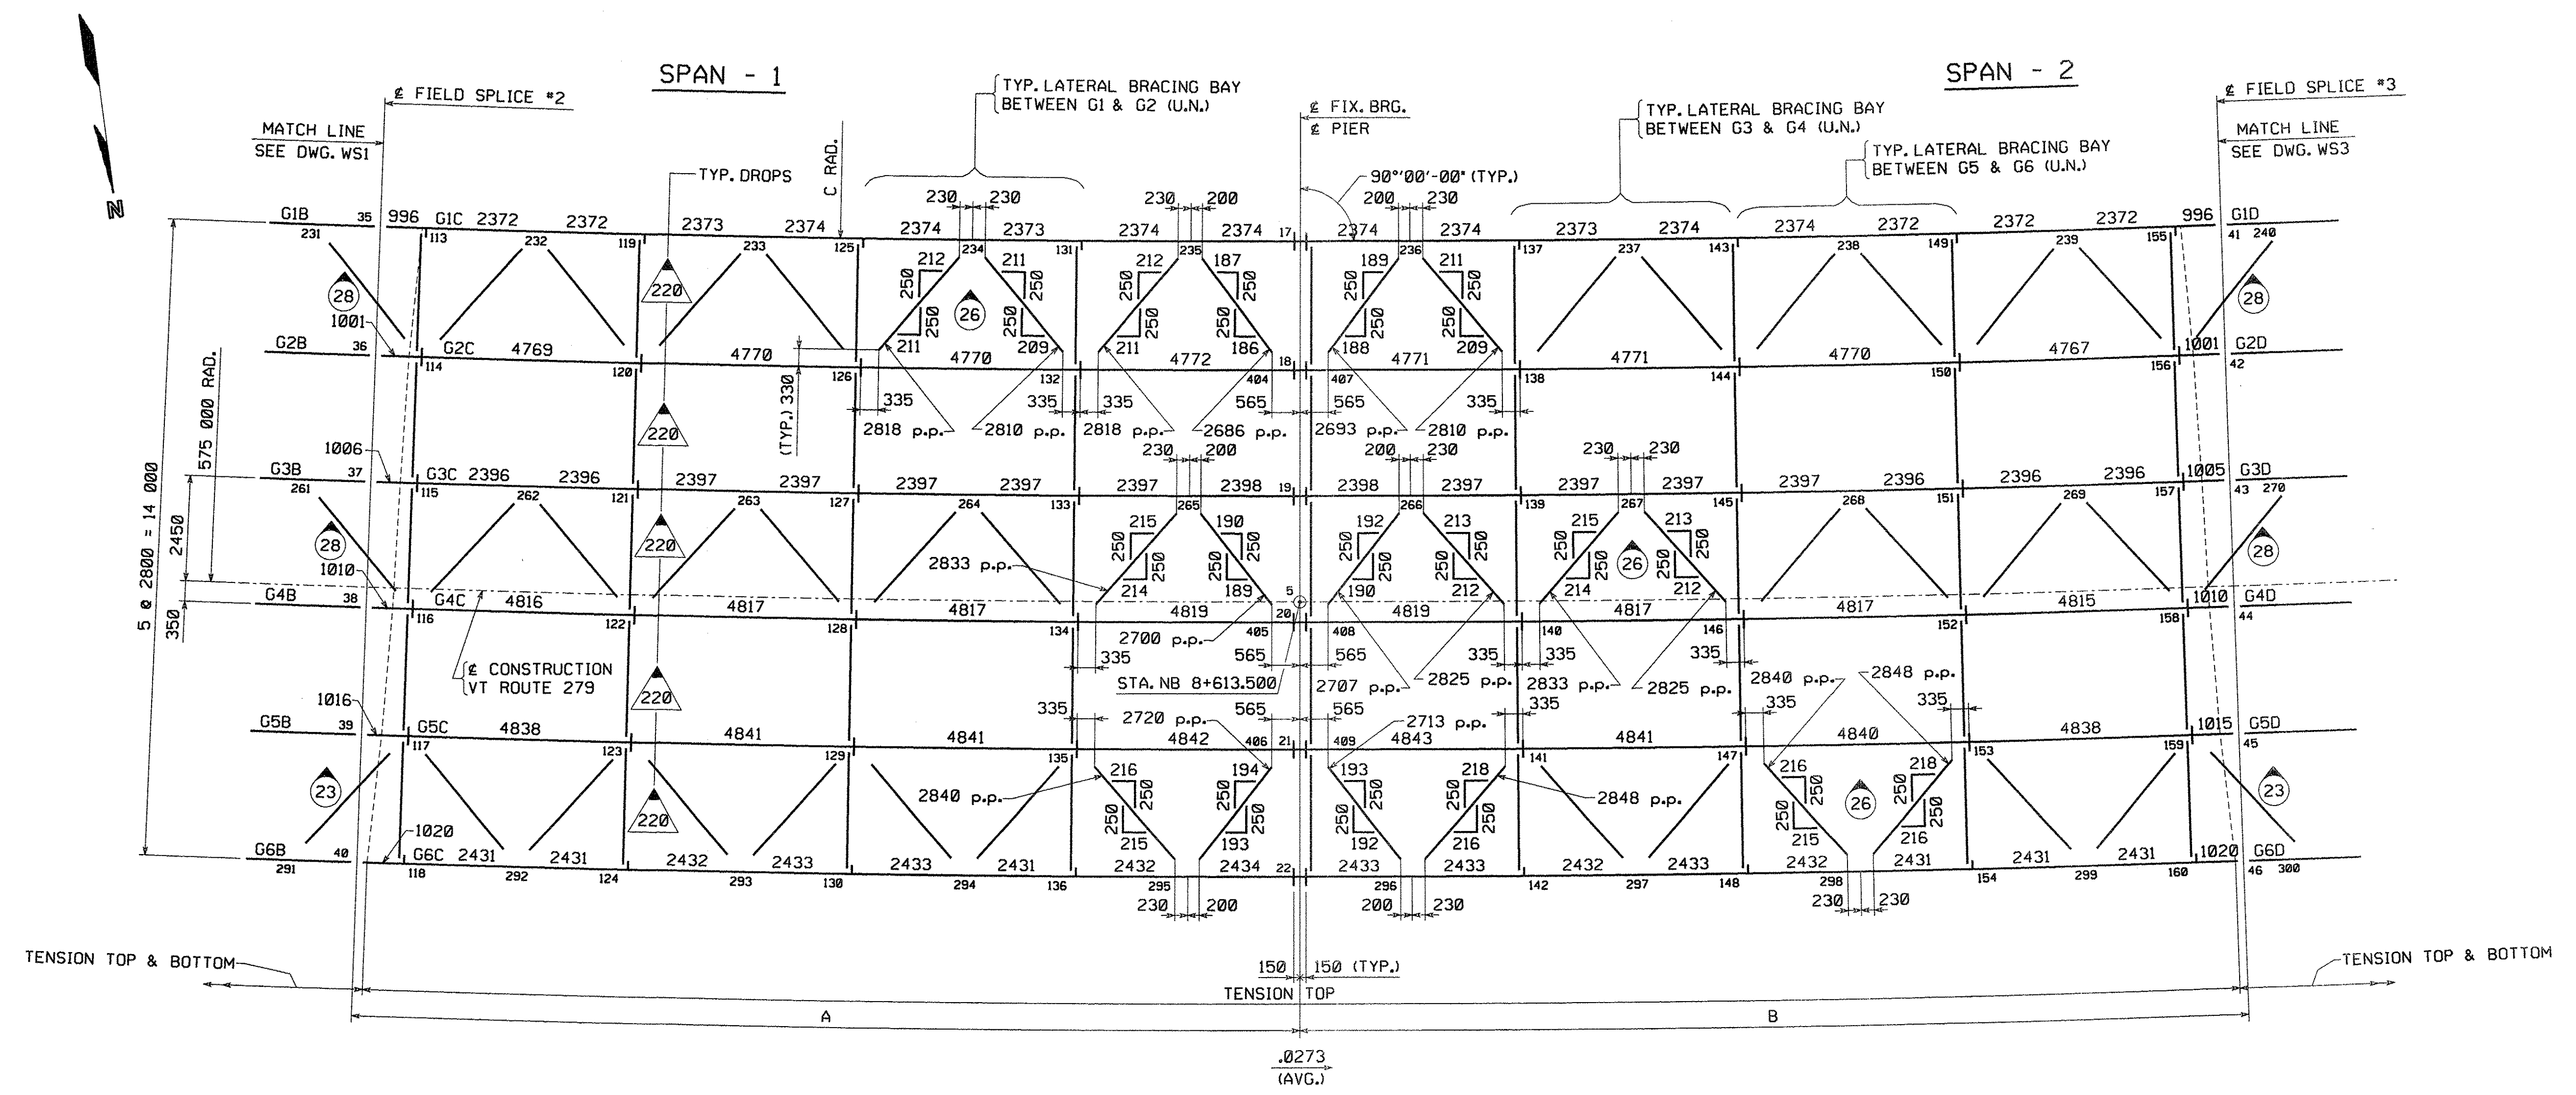

CALCULATION PLAN

NOTES:
 FOR NOTES, SEE DRAWING WS1.
 WORK THIS DRAWING WITH DRAWINGS WS1 & WS3.

| LINE | A | B | C |
|------|--------|--------|---------|
| G1 | 19 982 | 19 981 | 566 950 |
| G2 | 20 082 | 20 080 | 569 750 |
| G3 | 20 181 | 20 179 | 572 550 |
| G4 | 20 279 | 20 278 | 575 350 |
| G5 | 20 378 | 20 377 | 578 150 |
| G6 | 20 477 | 20 476 | 580 950 |

TVGA CONSULTANTS

NO EXCEPTIONS TAKEN
 FURNISH AS CORRECTED
 REJECTED
 REVISE AND RESUBMIT
 ENGINEER has reviewed Shop Drawings and Samples and other data which Contractor is required to submit for conformance with the information given in the Contract Documents and compatibility with the design concept of the completed Project as a functioning whole as indicated in the Contract Documents. Such reviews do not extend to means, methods, techniques, sequences or procedures of construction or to safety precautions and programs incident thereto. Contractor is responsible for dimensions to be confirmed and correlated at the job site; for information that pertains solely to the fabrication processes or to techniques of construction; and for coordination of the work of all trades.
 BY: *[Signature]*
 DATE: 1/8/08

| | | | | |
|---|----------|---------------------|---------------|----------------------------|
| NO. | REVISION | BY | CHK'D | DATE |
| | | | | |
| WORKSHEET - CALCULATION PLAN VT ROUTE 279 OVER FURNACE BROOK VT ROUTE 279 STA. 8+542.000 TO STA. 8+685.000 TOWN OF BENNINGTON VERMONT, BRIDGE B12 STATE OF VERMONT AGENCY OF TRANSPORTATION | | | | |
| SCALE | | AC NH F019-(153) | | FED. AID PROJ. NO. |
| GENERAL CONTRACTOR | | J.A. McDONALD, INC. | | HSSI PROJ. MGR. DEB KUPRES |
| SHIPT | 3 | DRAWING MANAGER | BRITIGAN (IH) | MADE BY |
| STATE | VT | HSSI PROJECT NUMBER | S-1070147 | DATE |
| | | STRUCT. ID | A | DATE |
| | | DRAWING NUMBER | WS2 OF WS3 | DATE |

****NOTE****
 THE PURPOSE OF THIS DRAWING IS TO COORDINATE GEOMETRIC CONTROL INFORMATION. THIS DRAWING IS SUBMITTED FOR INFORMATION ONLY AND IS NOT INTENDED FOR SHOP FABRICATION. THIS DRAWING IS FOR REFERENCE ONLY, APPROVAL IS NOT REQUIRED.