


METRIC Scale = 0.012000 of full size. SHIPMENT 01 P&ENG: 500281Z PRD: 500281B SHIPPERECT: 500281S BY: MKreide1 PLOTTED: 11/30/2007 12:43:34 PM 60

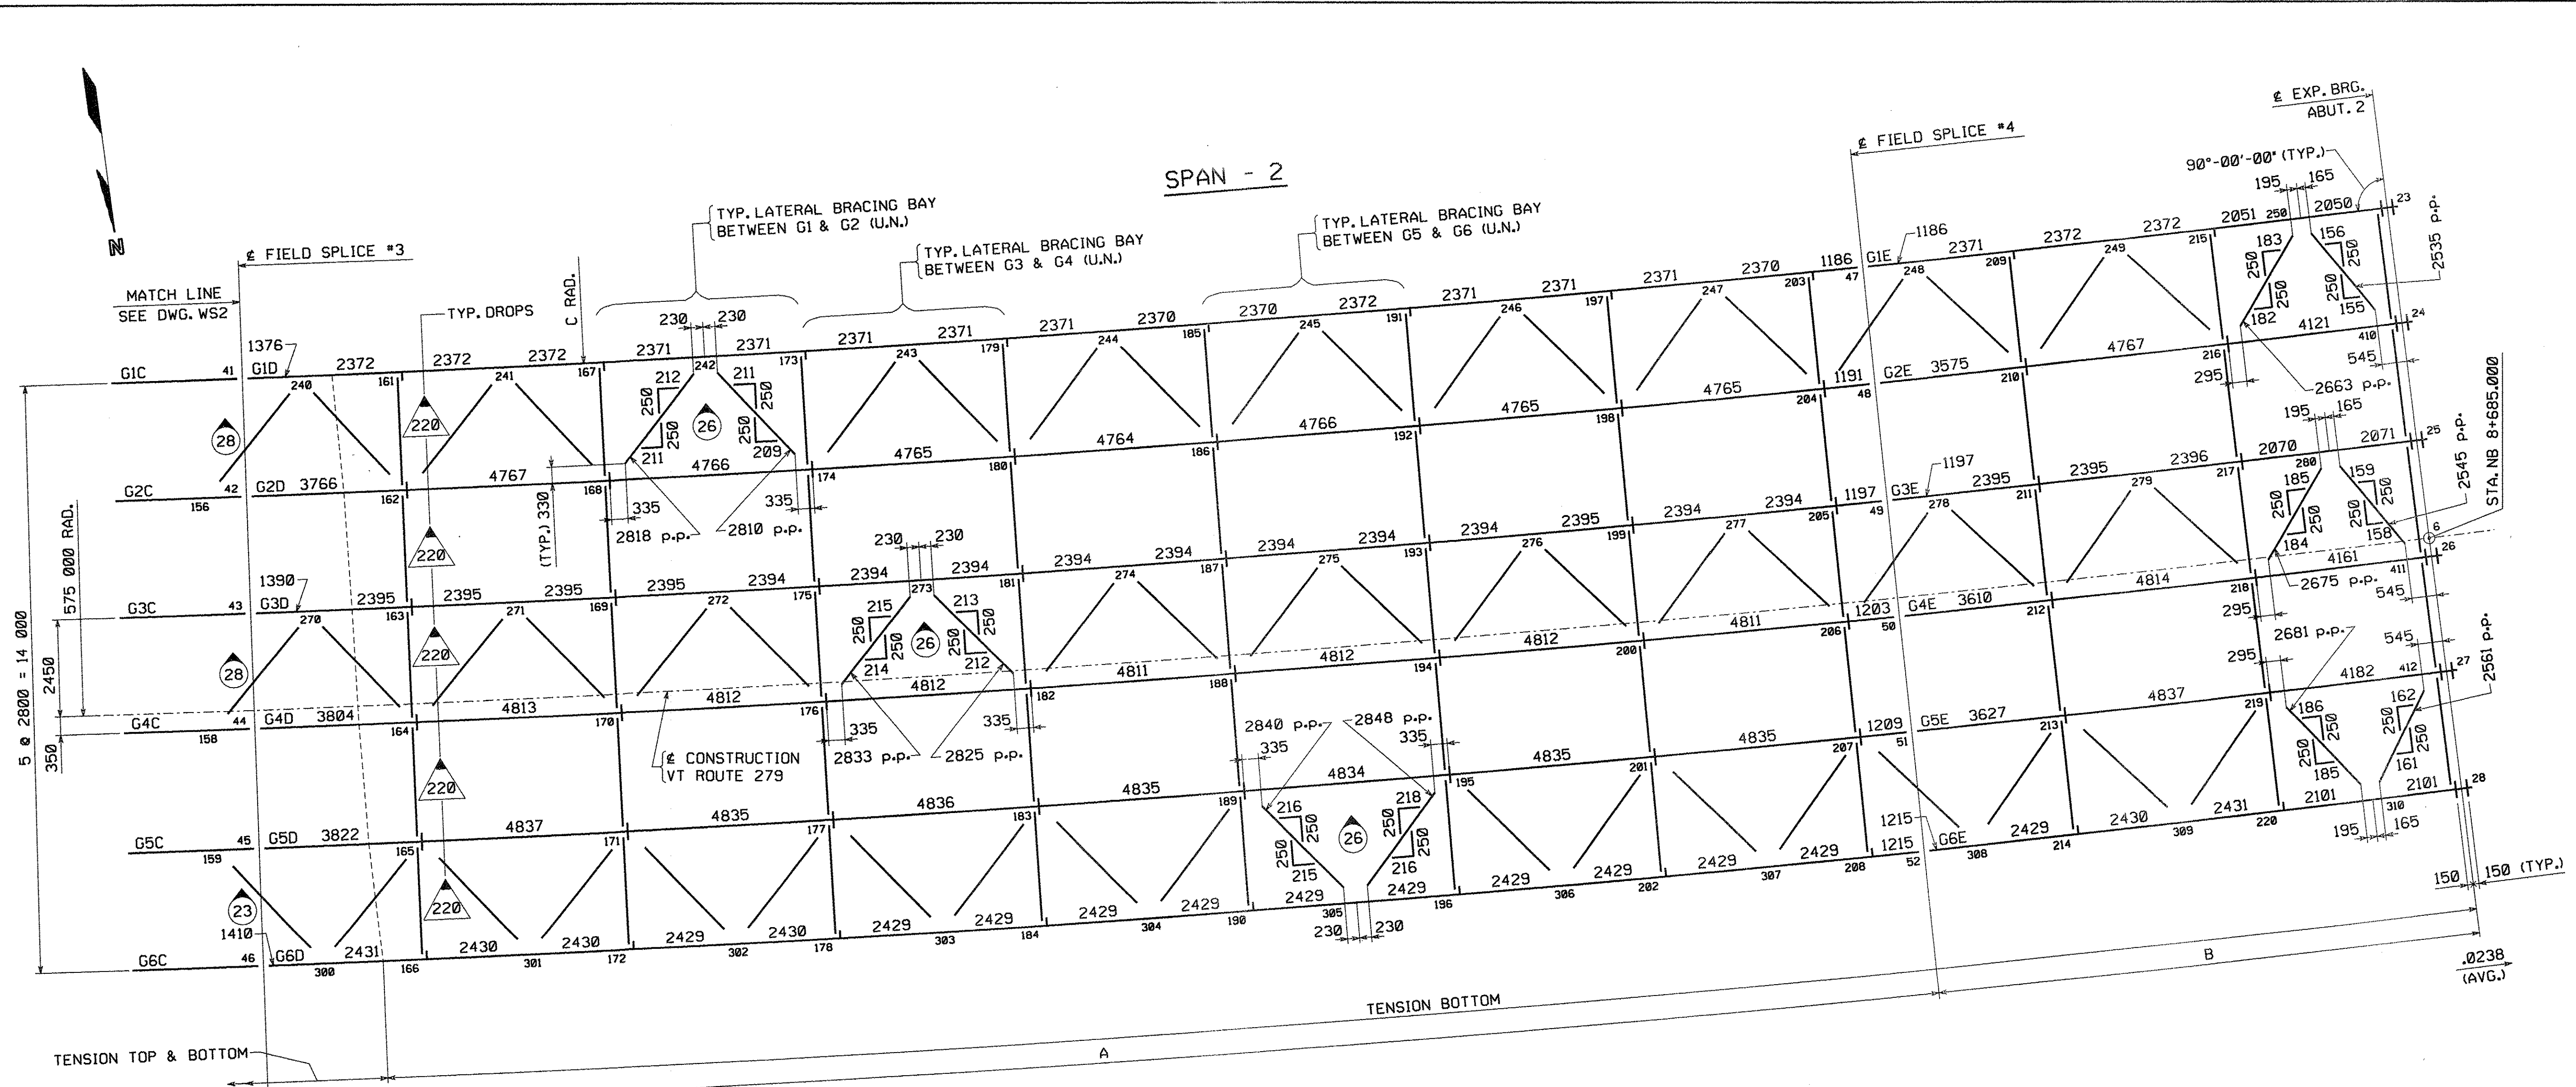

**CALCULATION PLAN**

**NOTES:**  
 FOR NOTES, SEE DRAWING WS1.  
 WORK THIS DRAWING WITH DRAWINGS WS1 & WS2.

LINE	A	B	C
G1	38 128	12 402	566 950
G2	38 315	12 463	569 750
G3	38 502	12 524	572 550
G4	38 690	12 585	575 350
G5	38 878	12 646	578 150
G6	39 065	12 707	580 950

**\*\*NOTE\*\***  
 THE PURPOSE OF THIS DRAWING IS TO COORDINATE GEOMETRIC CONTROL INFORMATION. THIS DRAWING IS SUBMITTED FOR INFORMATION ONLY AND IS NOT INTENDED FOR SHOP FABRICATION. THIS DRAWING IS FOR REFERENCE ONLY, APPROVAL IS NOT REQUIRED.

**TVGA CONSULTANTS**

NO EXCEPTIONS TAKEN  REJECTED  
 FURNISH AS CORRECTED  
 REVISE AND RESUBMIT  
 ENGINEER has reviewed Shop Drawings and Samples and other data which Contractor is required to submit, only for conformance with the information given in the Contract Documents and compliance with the design concept of the completed Project as a functioning whole as indicated in the Contract Documents. Such reviews do not extend to means, methods, techniques, sequences or procedures of construction or to safety precautions and programs incident thereto. Contractor is responsible for dimensions to be confirmed and controlled at the job site; for information that pertains solely to the fabrication processes or to techniques of construction; and for coordination of the work of all trades.  
 BY: *[Signature]*  
 DATE: 1/1/07

NO.	REVISION	BY	CHK'D	DATE
<b>WORKSHEET - CALCULATION PLAN</b> VT ROUTE 279 OVER FURNACE BROOK VT ROUTE 279 STA. 8+542.000 TO STA. 8+685.000 TOWN OF BENNINGTON VERMONT, BRIDGE B12 STATE OF VERMONT AGENCY OF TRANSPORTATION				
SCALE	AC NH F019-1(53)		FED. AID	
N.T.S.			PROJ. NO.	
GENERAL CONTRACTOR	J.A. McDONALD, INC.		ISSI PROJ. MGR	DEB KUPRES
SHPMT	3	DRAWING MANAGER	BRITIGAN (IH)	MADE BY
STATE	VT	ISSI PROJECT NUMBER	S-1070147	CHK'D BY
		ISSI STRUCT. ID	A	DATE
		ISSI DRAWING NUMBER	WS3 OF WS3	11-14-07