



METRIC

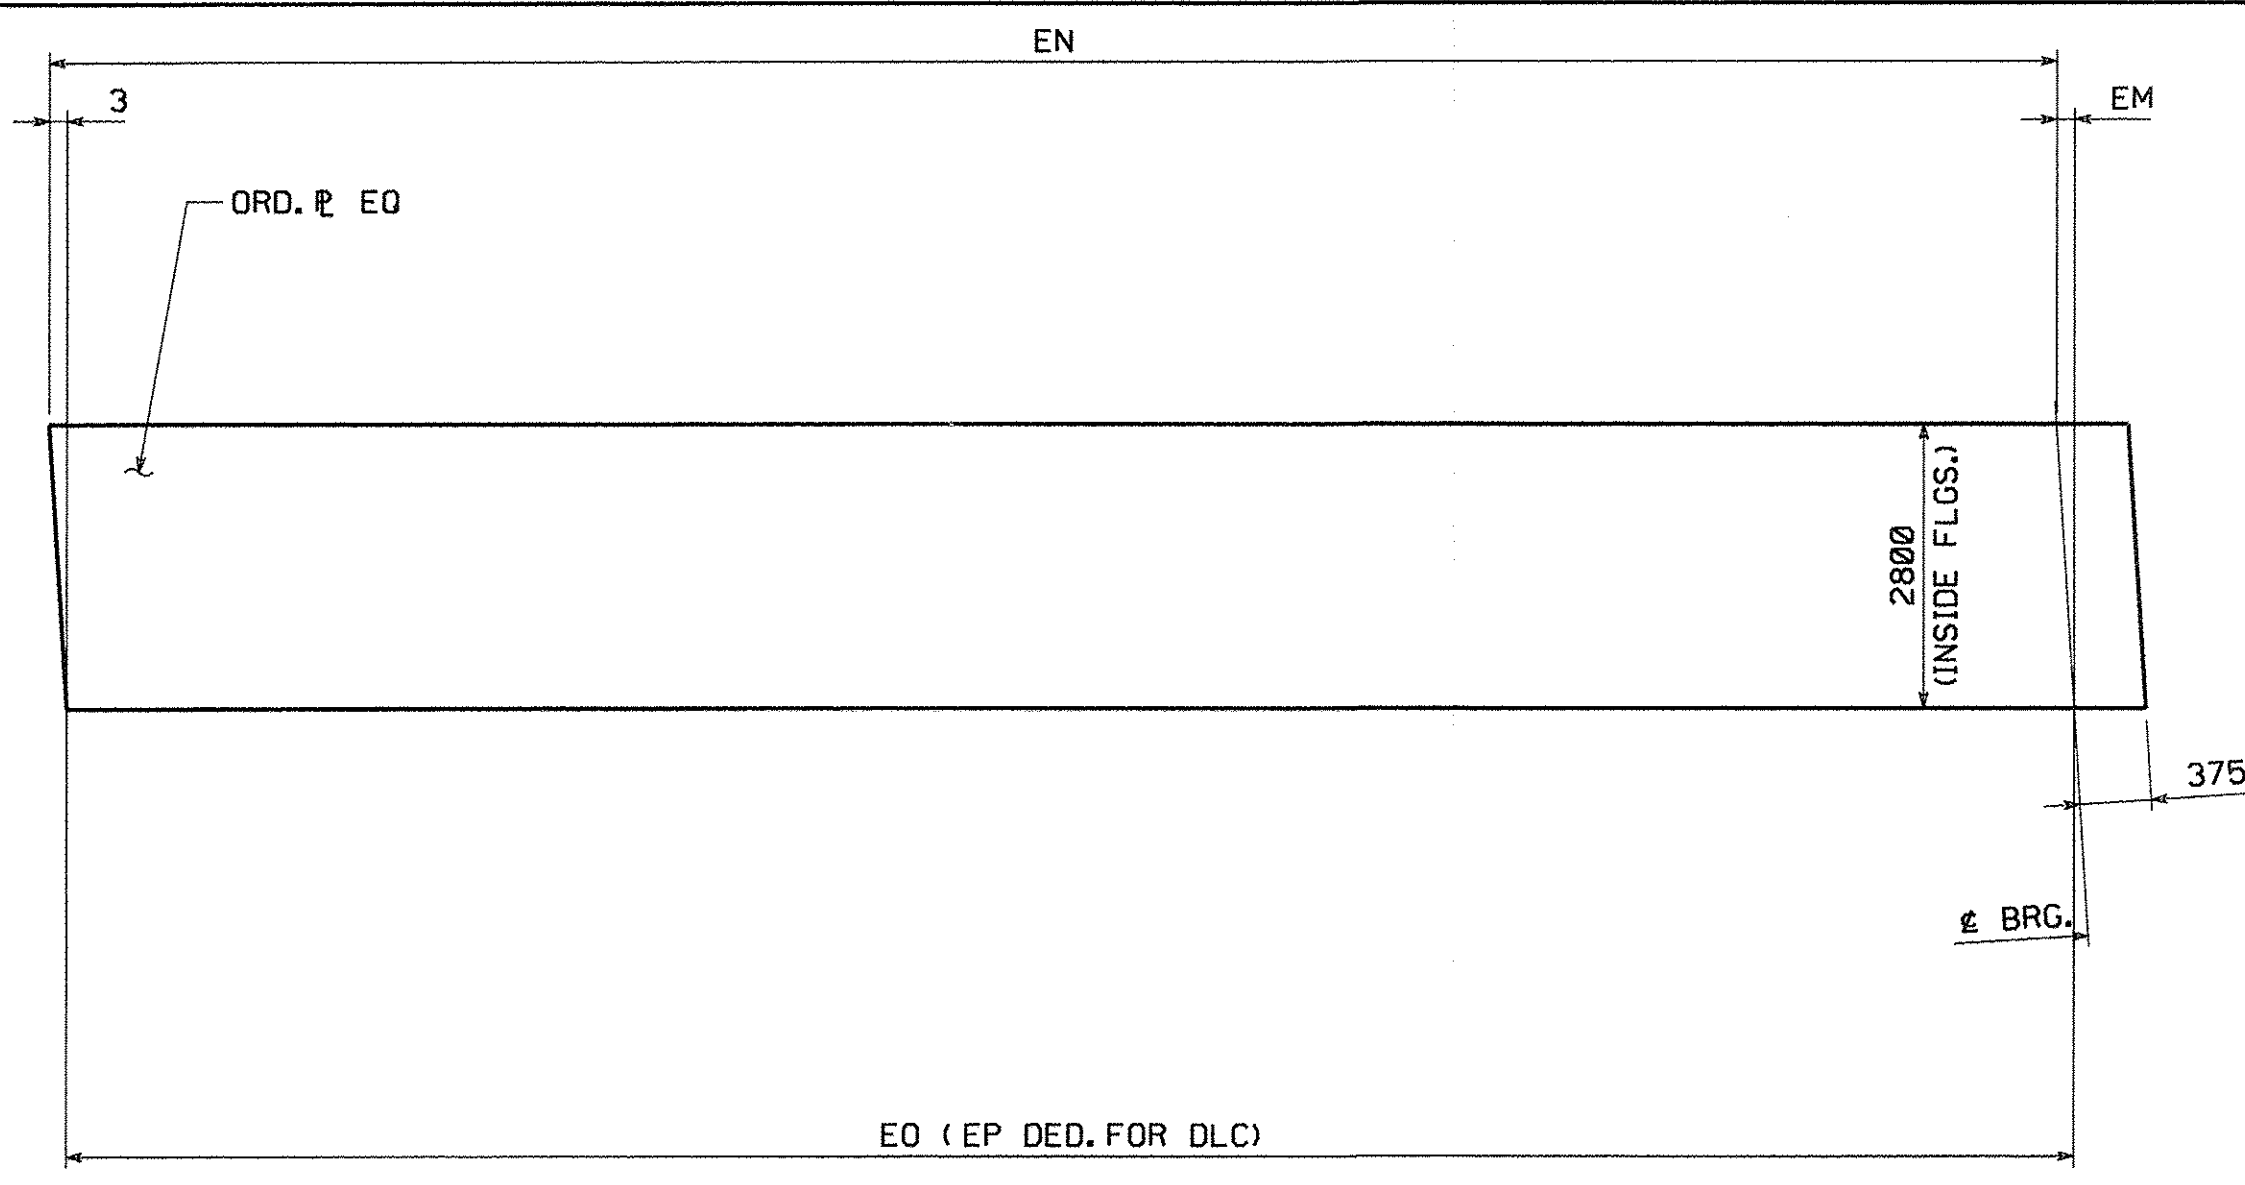

| MARK | EM | EN | EO | EP | EO |
|------|----|--------|--------|----|----------------------------|
| G1E | 67 | 12 335 | 12 399 | 0 | 22 x 2840 x 12 960 (03011) |
| G2E | 65 | 12 398 | 12 460 | 1 | 22 x 2840 x 12 960 (03011) |
| G3E | 65 | 12 459 | 12 521 | 1 | 22 x 2840 x 12 960 (03011) |
| G4E | 64 | 12 521 | 12 582 | 1 | 22 x 2840 x 13 020 (03009) |
| G5E | 65 | 12 581 | 12 643 | 1 | 22 x 2840 x 13 080 (03009) |

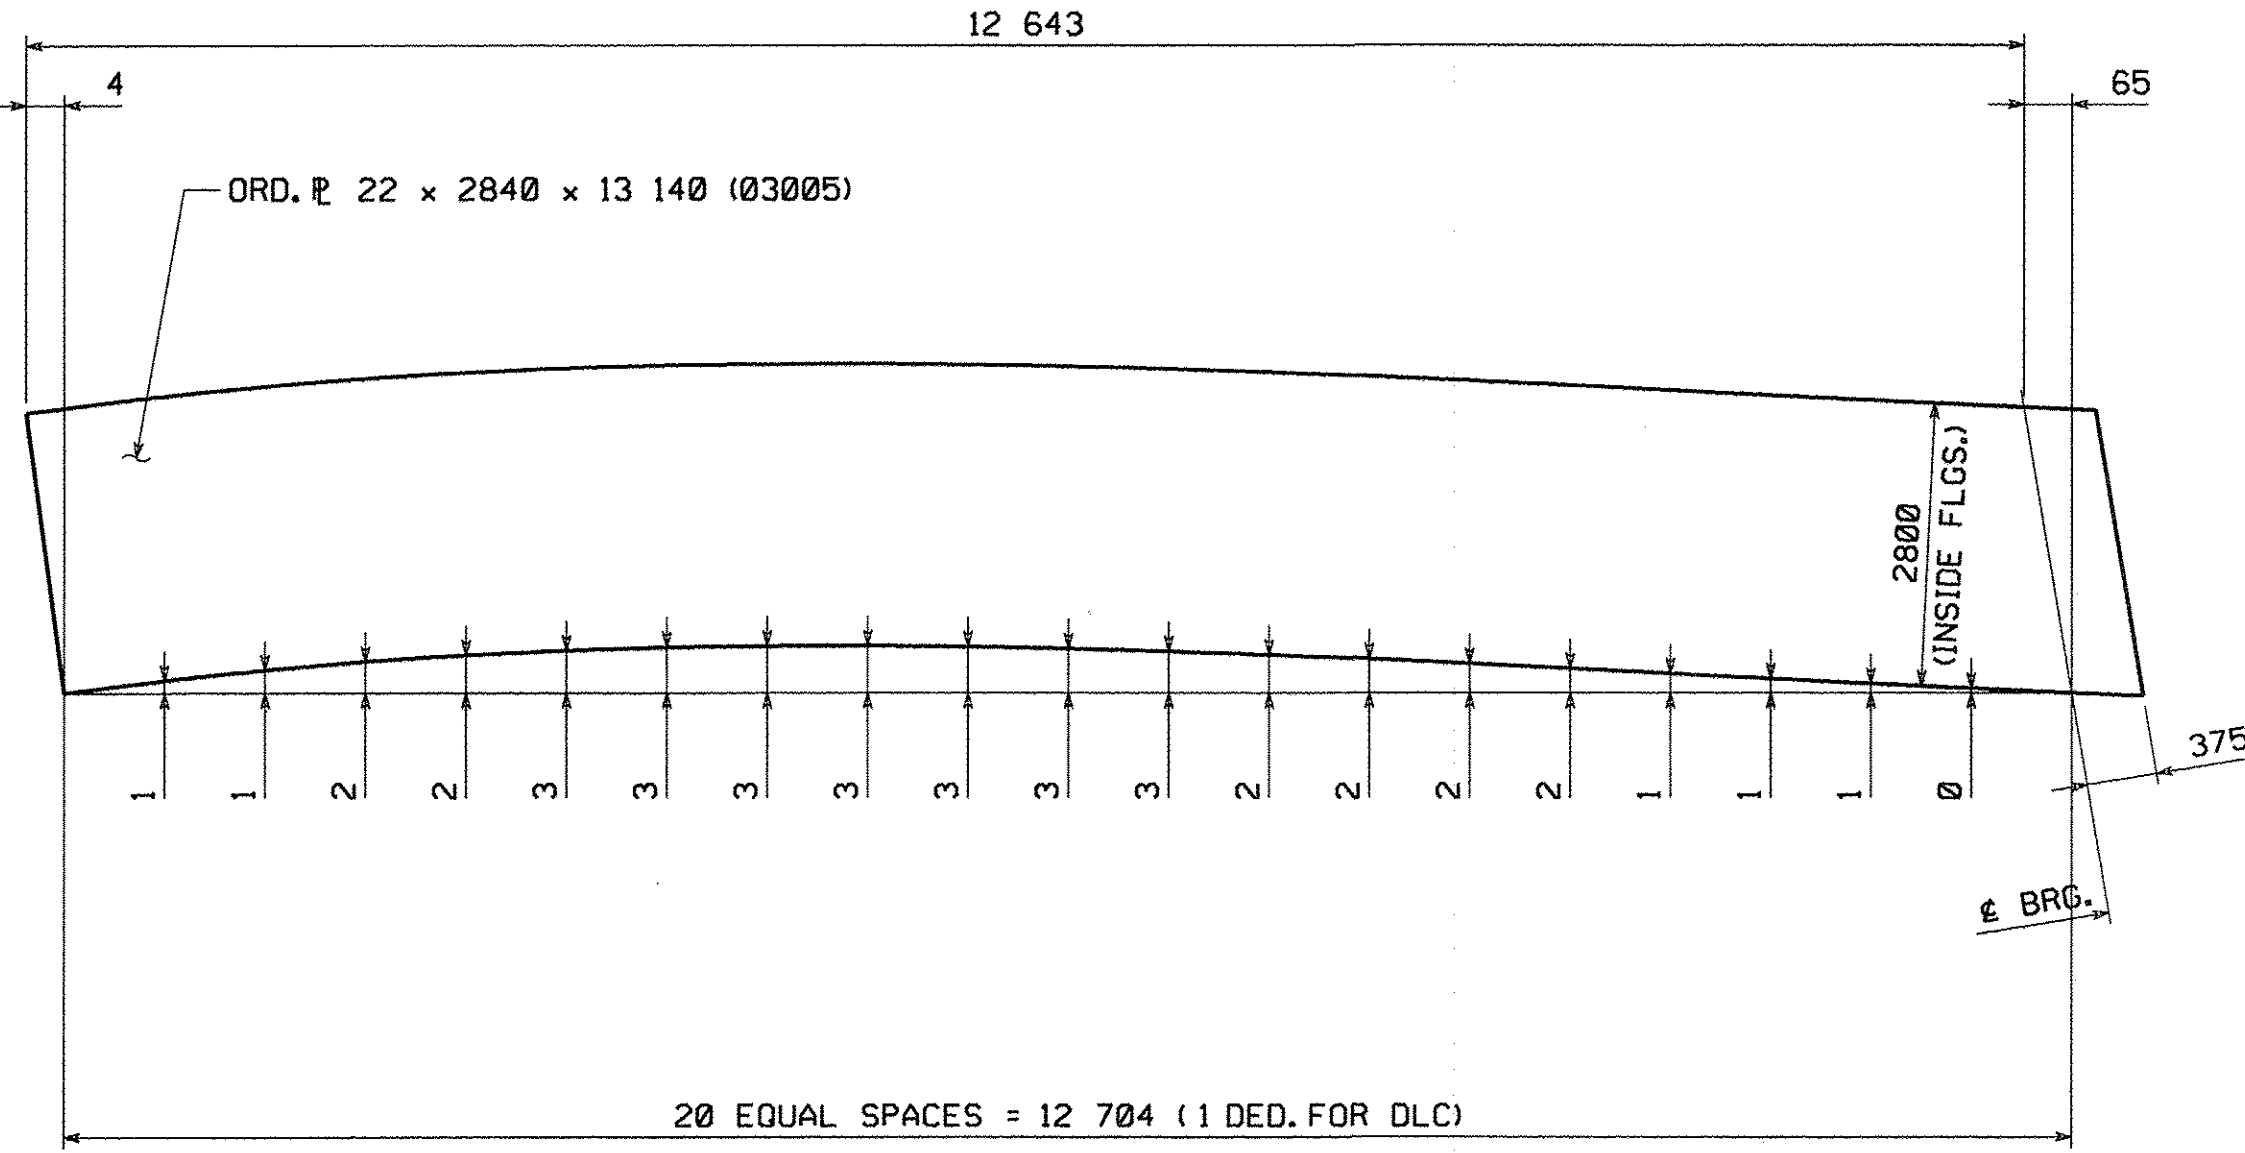

CAMBER DIAGRAM - G6E

TVGA CONSULTANTS

NO EXCEPTIONS TAKEN REJECTED
 FURNISH AS CORRECTED
 REVISE AND RESUBMIT

ENGINEER has reviewed Shop Drawings and Samples and other data which Contractor is required to submit, only for conformance with the information given in the Contract Documents and compatibility with the design concept of the completed Project as a functioning whole as indicated in the Contract Documents. Such reviews do not extend to means, methods, techniques, sequences or procedures of construction or to safety precautions and programs incident thereto. Contractor is responsible for dimensions to be confirmed and correlated at the job site for information that pertains solely to the fabrication processes or to techniques of construction, and for coordination of the work of all trades.

BY: *[Signature]*
 DATE: 1/10/08

NOTES:
 FOR WELDING DETAILS AND OTHER NOTES, SEE DWG. WC1.

SHIPMENT 01 PKMENG: 50002818 SHIPPERECT: 50002819
 BY: Mkr-cuda1
 PLOTTED: 11/30/2007 12:43:26 PM

| NO. | REVISION | BY | CHK'D | DATE |
|---------|--|---------------------|-----------------|-----------------|
| | | | | |
| | | | | |
| | | | | |
| HOLES | | | | |
| BOLTS | | | | |
| COATING | VT ROUTE 279 OVER FURNACE BROOK VT ROUTE 279 STA. 8+542.000 TO STA. 8+685.000 TOWN OF BENNINGTON VERMONT, BRIDGE B12 | | | |
| CODE(S) | STATE OF VERMONT AGENCY OF TRANSPORTATION | | | |
| SCALE | AC NH F019-1(53) | | | |
| N.T.S. | GENERAL CONTRACTOR J.A. McDONALD, INC. | MADE BY KMA | CHK'D BY SJA | DATE 9/13/07 |
| SHPMT | 3 | DRAWING MANAGER | BRITIGAN (IH) | DATE |
| STATE | VT | HSSI PROJECT NUMBER | S-1070147 | HSSI STRUCT. ID |
| | | DRAWING NUMBER | WC3 OF WC3 | |