




METRIC

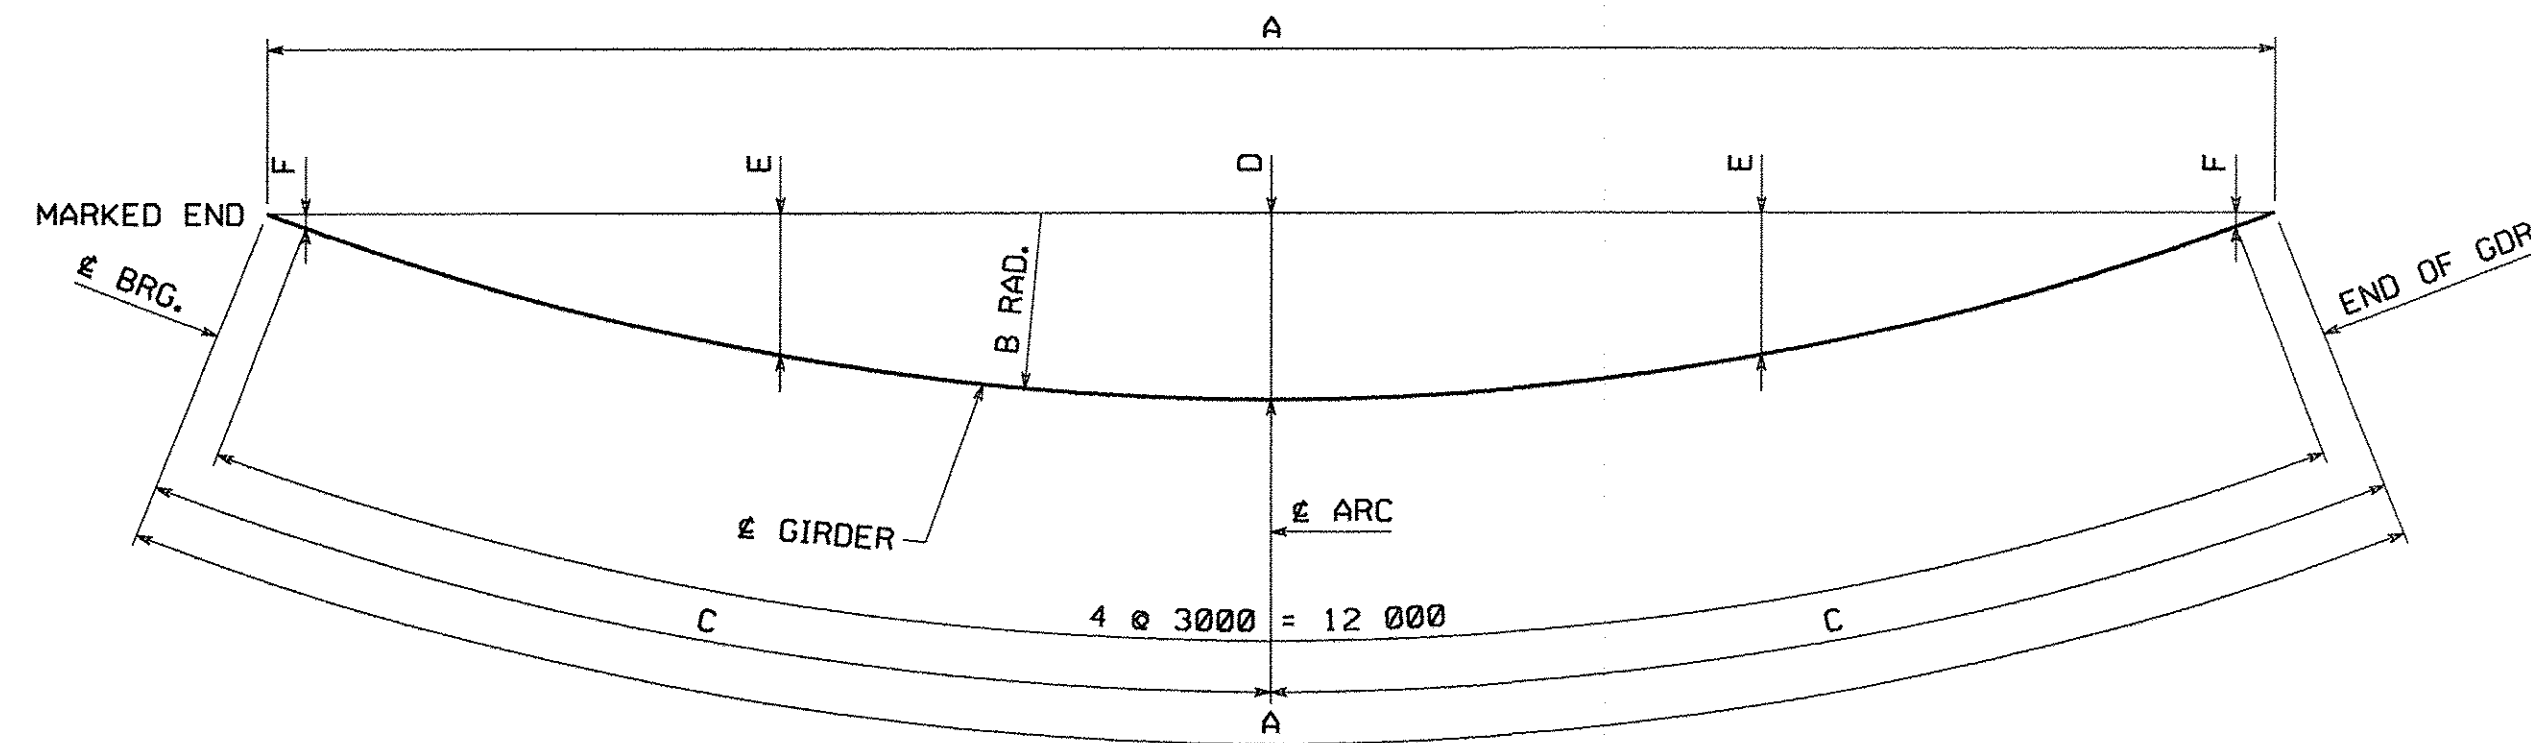

MARK	A	B	C	D	E	F
G1A	12 504	566 950	6252	34	27	3
G2A	12 565	569 750	6283	35	27	3
G3A	12 624	572 550	6312	35	27	3
G4A	12 684	575 350	6342	35	27	4
G5A	12 746	578 150	6373	35	27	4
G6A	12 808	580 950	6404	35	28	4

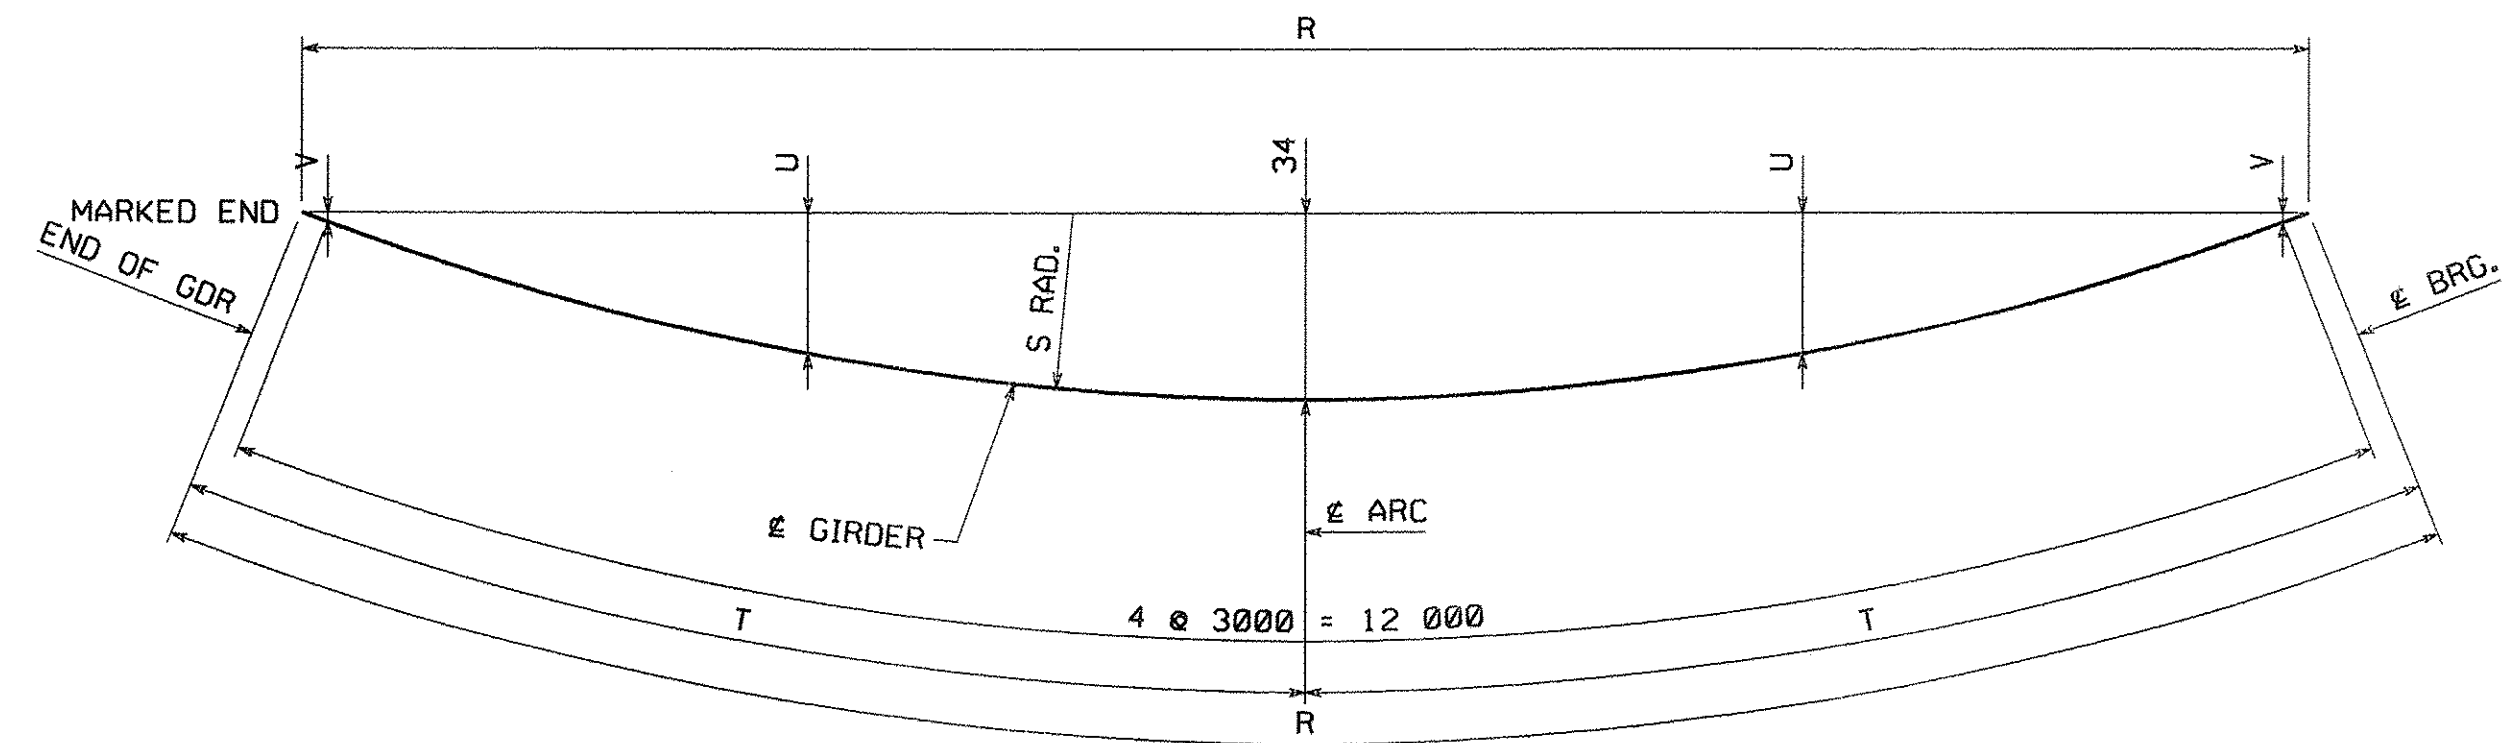

MARK	R	S	T	U	V
G1E	12 335	566 950	6168	26	2
G2E	12 398	569 750	6199	26	2
G3E	12 459	572 550	6230	26	2
G4E	12 521	575 350	6261	26	3
G5E	12 581	578 150	6291	26	3
G6E	12 643	580 950	6322	27	3

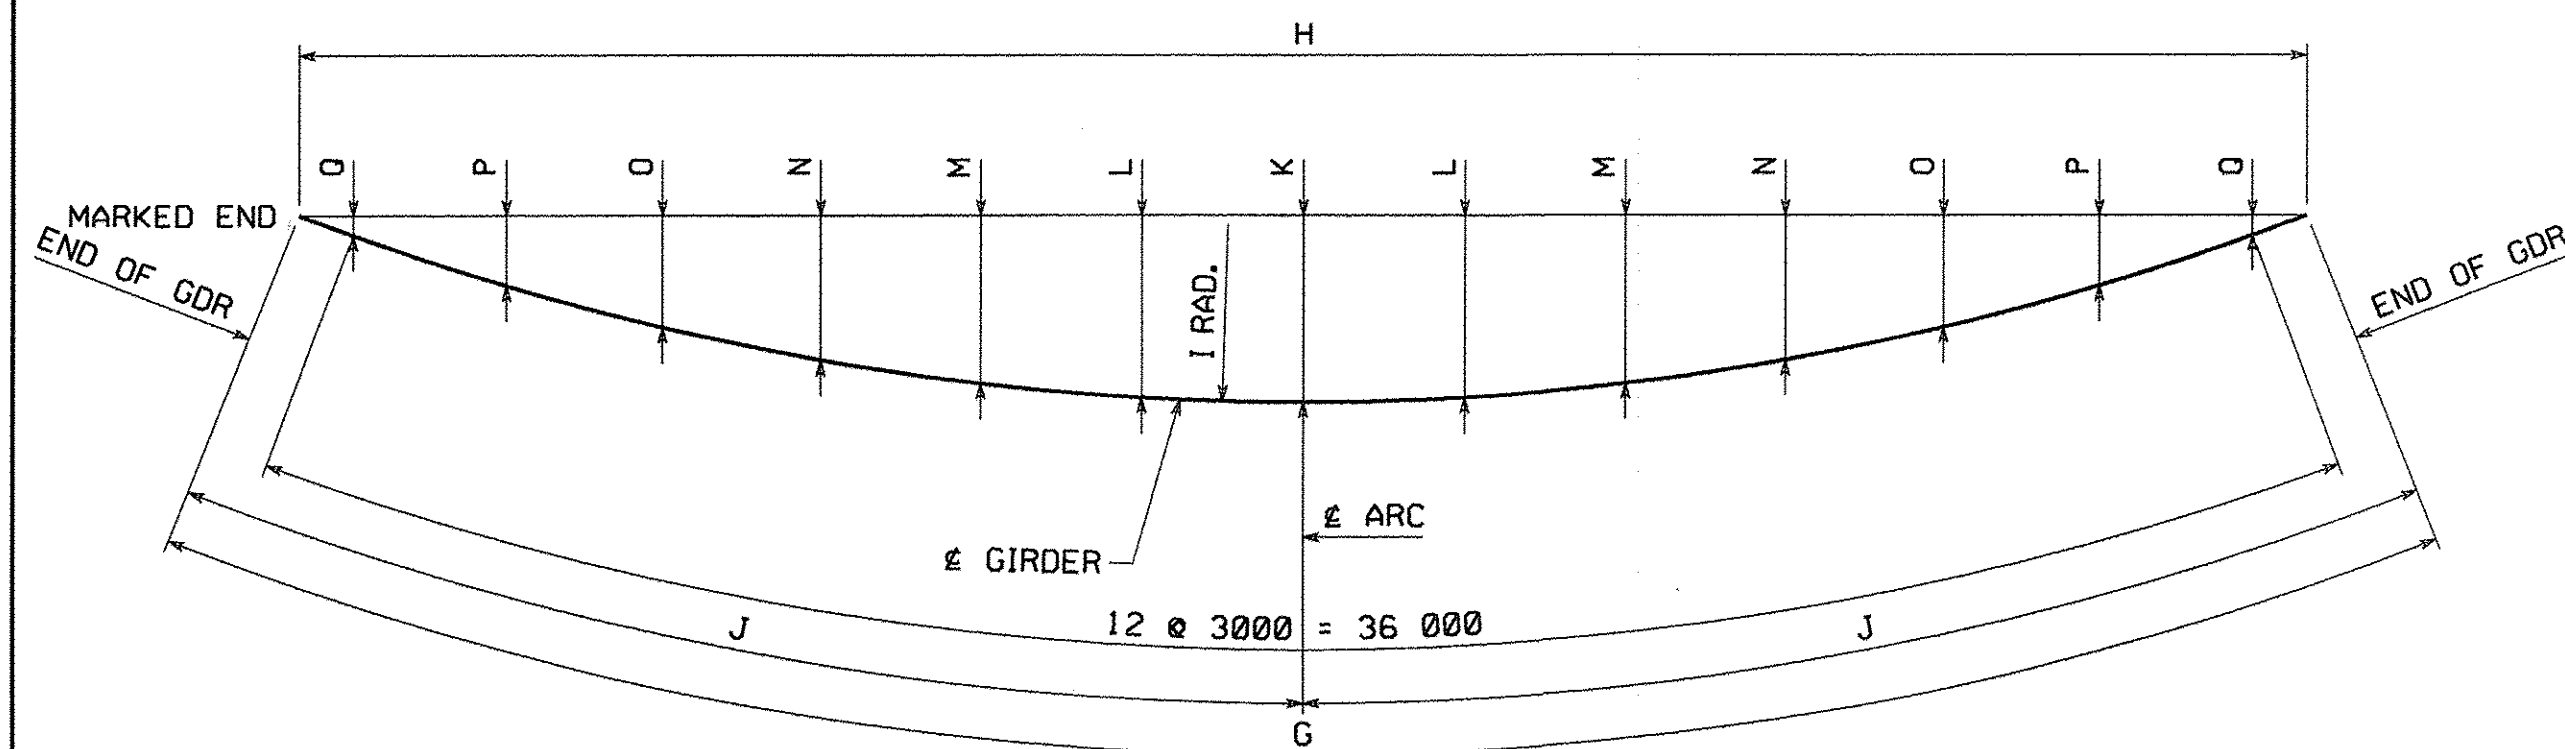

MARK	G	H	I	J	K	L	M	N	O	P	Q
G1B	38 149	38 142	566 950	19 075	321	313	289	249	194	122	35
G2B	38 339	38 332	569 750	19 170	322	315	291	251	196	125	38
G3B	38 528	38 521	572 550	19 264	324	316	293	253	198	128	41
G4B	38 716	38 709	575 350	19 358	326	318	294	255	200	130	44
G5B	38 906	38 899	578 150	19 453	327	319	296	257	203	133	47
G6B	39 095	39 088	580 950	19 548	329	321	298	259	205	135	50
G1C	39 915	39 907	566 950	19 958	351	343	319	280	224	153	66
G2C	40 111	40 103	569 750	20 056	353	345	321	282	227	156	69
G3C	40 308	40 300	572 550	20 154	355	347	323	284	229	158	72
G4C	40 504	40 496	575 350	20 252	356	349	325	286	231	161	75
G5C	40 700	40 692	578 150	20 350	358	350	327	288	234	164	78
G6C	40 895	40 887	580 950	20 448	360	352	329	290	236	166	81
G1D	38 146	38 139	566 950	19 073	321	313	289	249	194	122	35
G2D	38 337	38 330	569 750	19 169	322	315	291	251	196	125	38
G3D	38 525	38 518	572 550	19 263	324	316	293	253	198	128	41
G4D	38 715	38 708	575 350	19 358	326	318	294	255	200	130	44
G5D	38 905	38 898	578 150	19 453	327	319	296	257	203	133	47
G6D	39 094	39 087	580 950	19 547	329	321	298	259	205	135	50

**TVGA CONSULTANTS**

NO EXCEPTIONS TAKEN  REJECT  
 FURNISH AS CORRECTED  
 REVISE AND RESUBMIT

ENGINEER has reviewed Shop Drawings and Samples and other data which Contractor is required to submit, both for performance with the information given in the Contract Documents and compatibility with the design concept of the completed Project as a functioning whole as indicated in the Contract Documents. Such review is not intended to verify methods, techniques, sequences or procedures of construction or to safety precautions and programs incident thereto. Contractor is responsible for dimensions to be confirmed and correlated at the job site; for information that pertains solely to the fabrication processes or to techniques of construction; and for coordination of the work of all trades.

BY: *[Signature]*  
 DATE: 1/16/08

**NOTES:**

ALL DIMENSIONS APPLY AT THE TOP OF WEB PLATE OF THE GIRDERS.

NO.	REVISION	BY	CHK'D	DATE
Holes				
BOLTS	An ISO 9001:2000 Certified Company An Affiliate of High Industries Inc.			
COATING	HORIZONTAL CURVE DIAGRAMS VT ROUTE 279 OVER FURNACE BROOK VT ROUTE 279 STA. 8+542.000 TO STA. 8+685.000 TOWN OF BENNINGTON VERMONT, BRIDGE B12			
CODE(S)	STATE OF VERMONT AGENCY OF TRANSPORTATION			
SCALE	AC NH F019-1(53)		FED. AID PROJ. NO.	
N.T.S.	GENERAL CONTRACTOR	J.A. McDONALD, INC.	HSSI PROJ. MGR	DEB KUPRES
SHIPMT	DRAWING MANAGER	BRITIGAN (IH)	MADE BY	KMA
STATE	HSSI PROJECT NUMBER	S-1070147	HSSI STRUCT. ID	A
	HSSI DRAWING NUMBER	HC1	OF	HC1
		DATE	9/13/07	

SHIPMENT 01 PANEING: 50628217 PRD: 50628218 SUPP&RECT: 50628219  
 BY: McErdel  
 PLOTTED: 11/20/2007 12:43:21 PM