


SHIPMENT 1 PMAENG: 5002BLZ PRD: 5002BLB SHIP&RECT: 5002BL3

BY: MKceidel

PLOTTED: 11/30/07 12:47:27

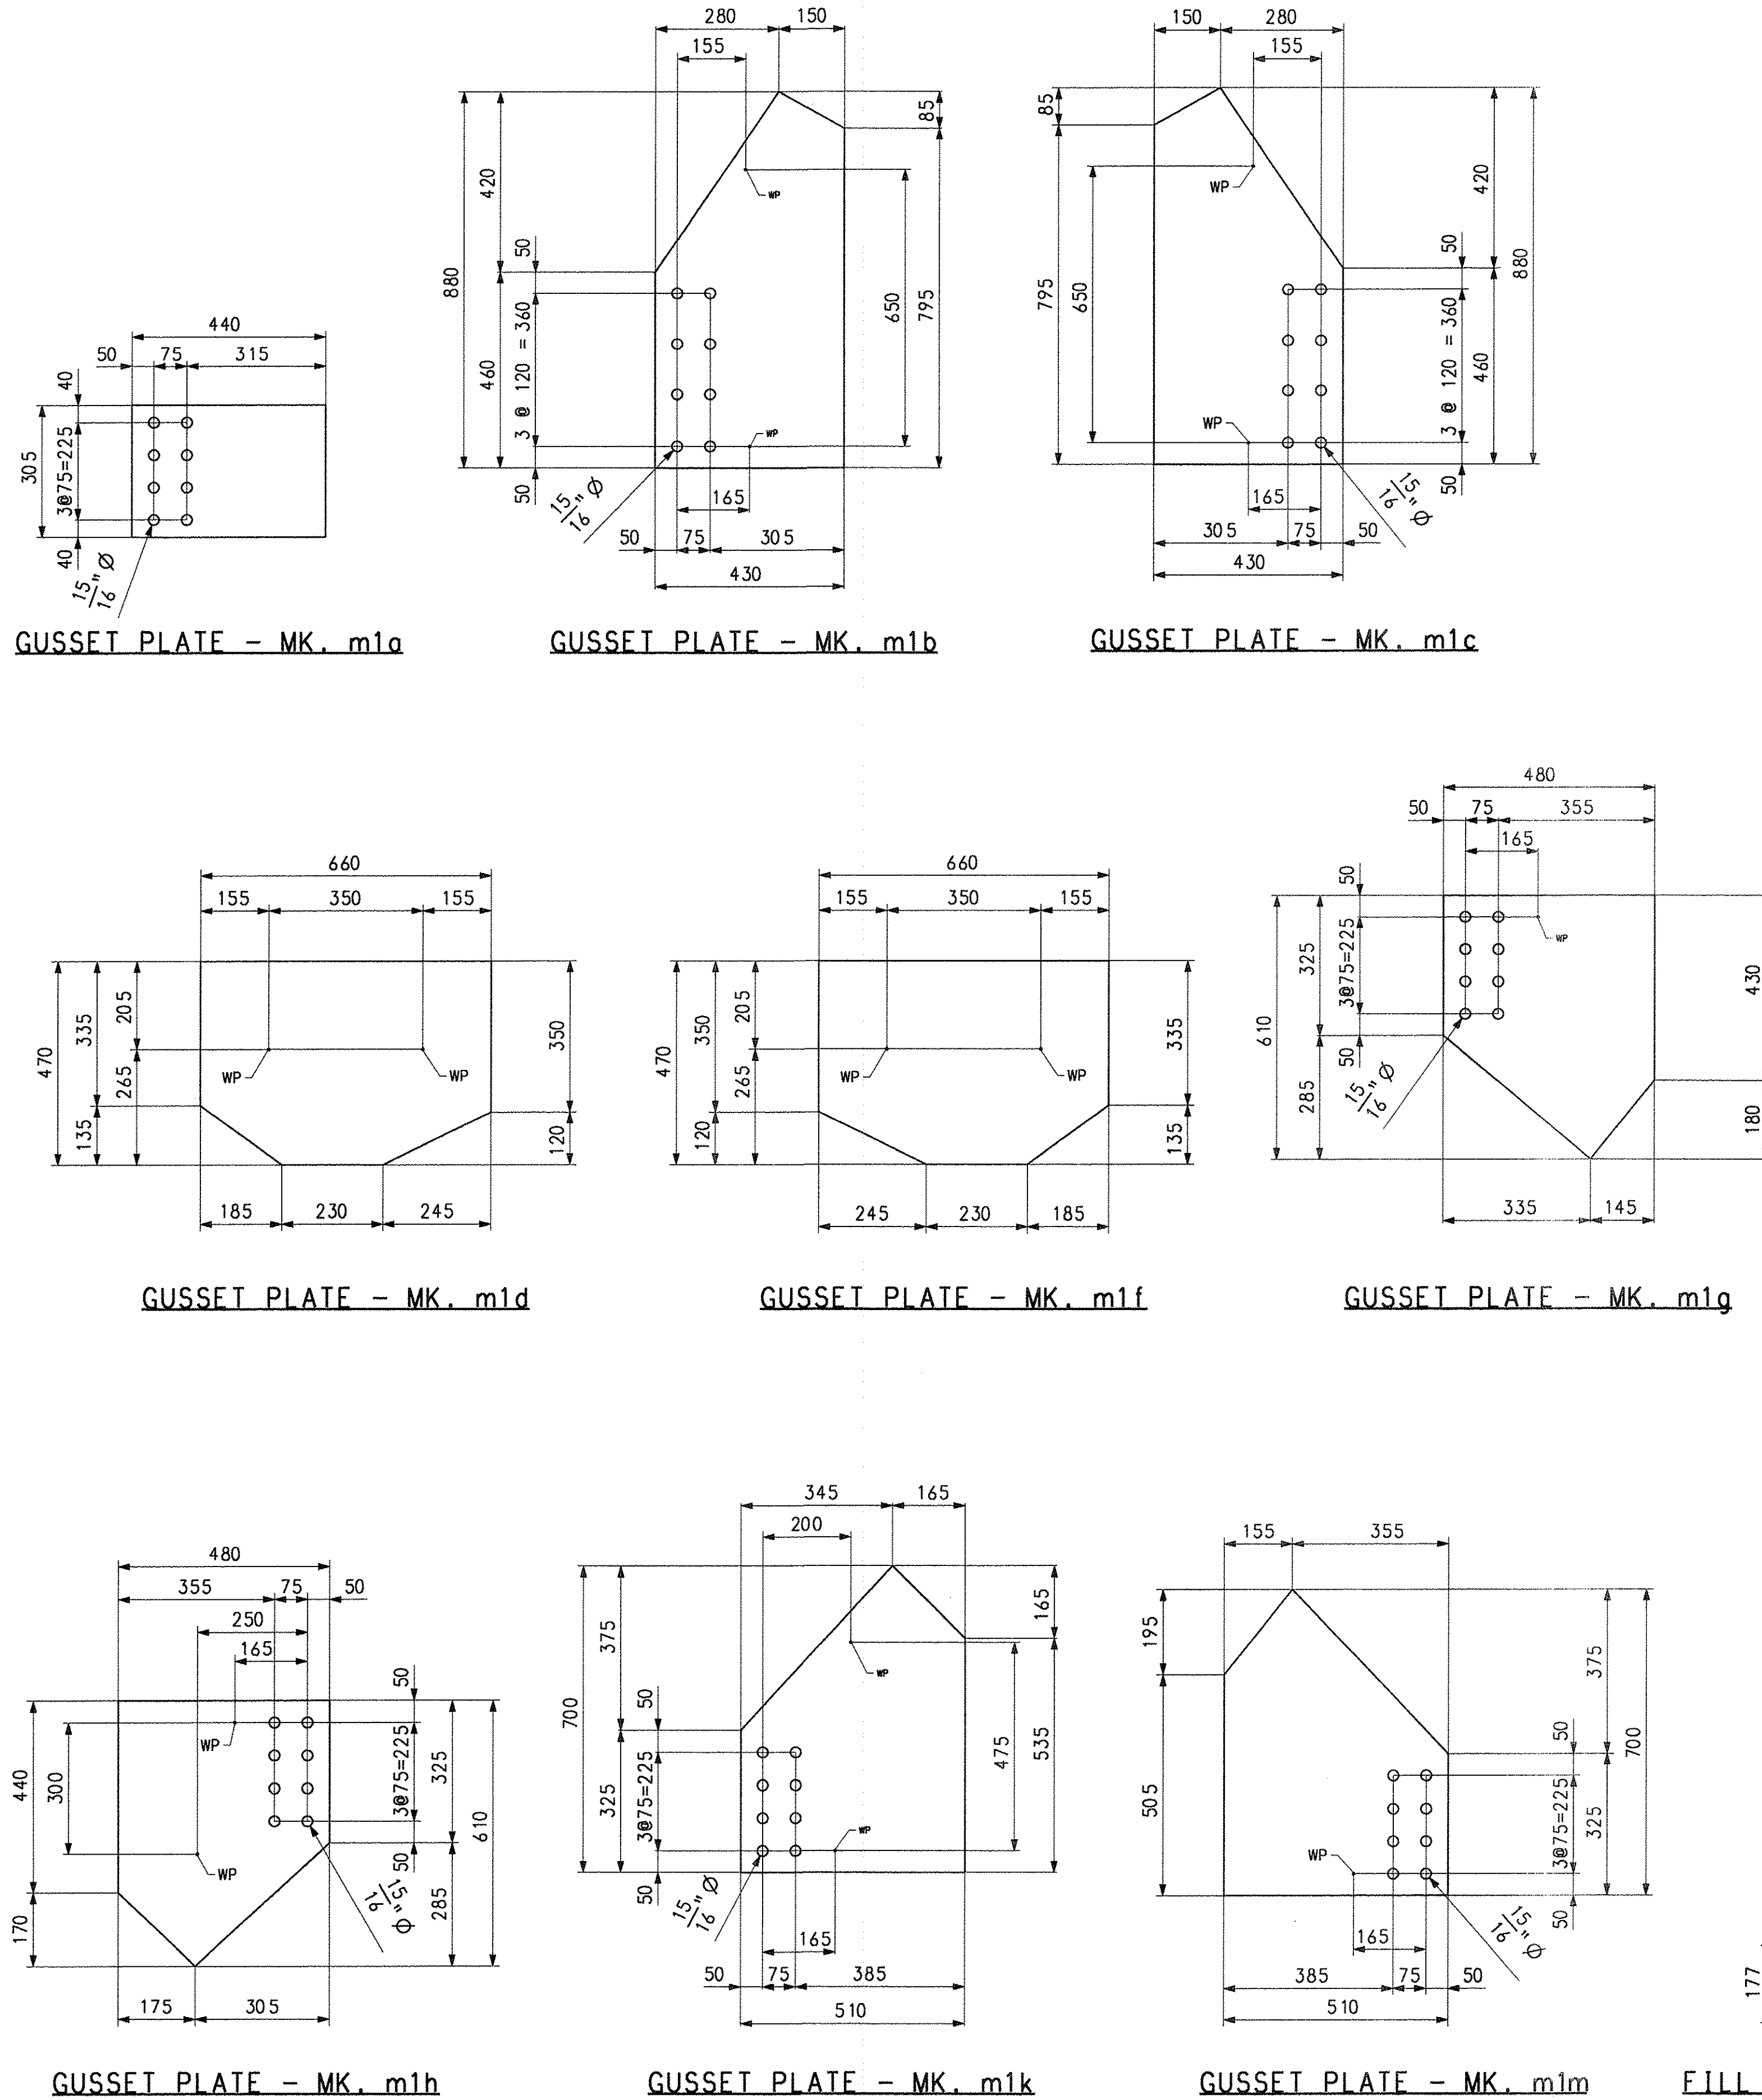

GUSSET PLATE - MK. m1a

GUSSET PLATE - MK. m1b

GUSSET PLATE - MK. m1c

GUSSET PLATE - MK. m1d

GUSSET PLATE - MK. m1f

GUSSET PLATE - MK. m1g

GUSSET PLATE - MK. m1h

GUSSET PLATE - MK. m1k

GUSSET PLATE - MK. m1m

FILL PLATE - MK. m1n

BILL OF MATERIAL

QTY	MARK	COMM.	DESCRIPTION	LENGTH	SPEC	GRADE	TEST	REMARKS	ITEM	GROSS WEIGHT EA.	DEDUCTED WEIGHT EA.	NET WEIGHT EA.
30	m1o	PL	14.3 x 305	440	M270M	345W	T		11003	15.06	0.00	15.06
15	m1b	PL	14.3 x 430	880	M270M	345W	T		11003	42.47	0.00	42.47
15	m1c	PL	14.3 x 430	880	M270M	345W	T		11003	42.47	0.00	42.47
5	m1d	PL	14.3 x 470	660	M270M	345W	T		11003	34.82	0.00	34.82
10	m1f	PL	14.3 x 470	660	M270M	345W	T		11003	34.82	0.00	34.82
140	m1g	PL	14.3 x 480	610	M270M	345W	T		11003	32.86	0.00	32.86
140	m1h	PL	14.3 x 480	610	M270M	345W	T		11003	32.86	0.00	32.86
140	m1k	PL	14.3 x 510	700	M270M	345W	T		11003	40.07	0.00	40.07
140	m1m	PL	14.3 x 510	700	M270M	345W	T		11003	40.07	0.00	40.07
140	m1n	PL	14.3 x 177	200	M270M	345W	T	FILL	11003	3.97	0.00	3.97

TVGA CONSULTANTS

NO EXCEPTIONS TAKEN REJECTED
 FURNISH AS CORRECTED
 REVISE AND RESUBMIT
 ENGINEER has reviewed Shop Drawings and Samples and other data which Contractor is required to submit, only for conformance with the information given in the Contract Documents and compatibility with the design concept of the completed Project as a functioning whole as indicated in the Contract Documents. Such reviews do not extend to means, methods, techniques, sequences or procedures of construction or to safety precautions and programs incident thereto. Contractor is responsible for dimensions to be confirmed and controlled at the job site, for information that pertains solely to the fabrication processes or to techniques of construction, and for coordination of the work of all trades.
 BY: *[Signature]*
 DATE: 1/10/08

NO.	REVISION	BY	CHK'D	DATE
HOLES 15/16" Ø				
BOLTS NONE				
COATING NONE				
CODE(S) 63				
SCALE N.T.S.				
STATE CONT. OR REF. NO. AC NH F019-1(53)				
FED. AID PROJ. NO. N.T.S.				
GENERAL CONTRACTOR J.A. McDONALD, INC.				
HSS1 PROJ. MGR DEB KUPRES				
SHIPMT	3	DRAWING MANAGER	BRITIGAN (IH)	MADE BY
STATE	VT	HSS1 PROJECT NUMBER	S-1070147	HSS1 STRUCT. ID
				ERS
				CHK'D BY
				CS
				DATE
				11-14-07
				DRAWING NUMBER
				M1 OF M1

NOTE:

ALL MATERIAL ON THIS DRAWING TO BE CORNER GROUND.
 FOR GENERAL SHOP NOTES, SEE DRAWING GN1.