
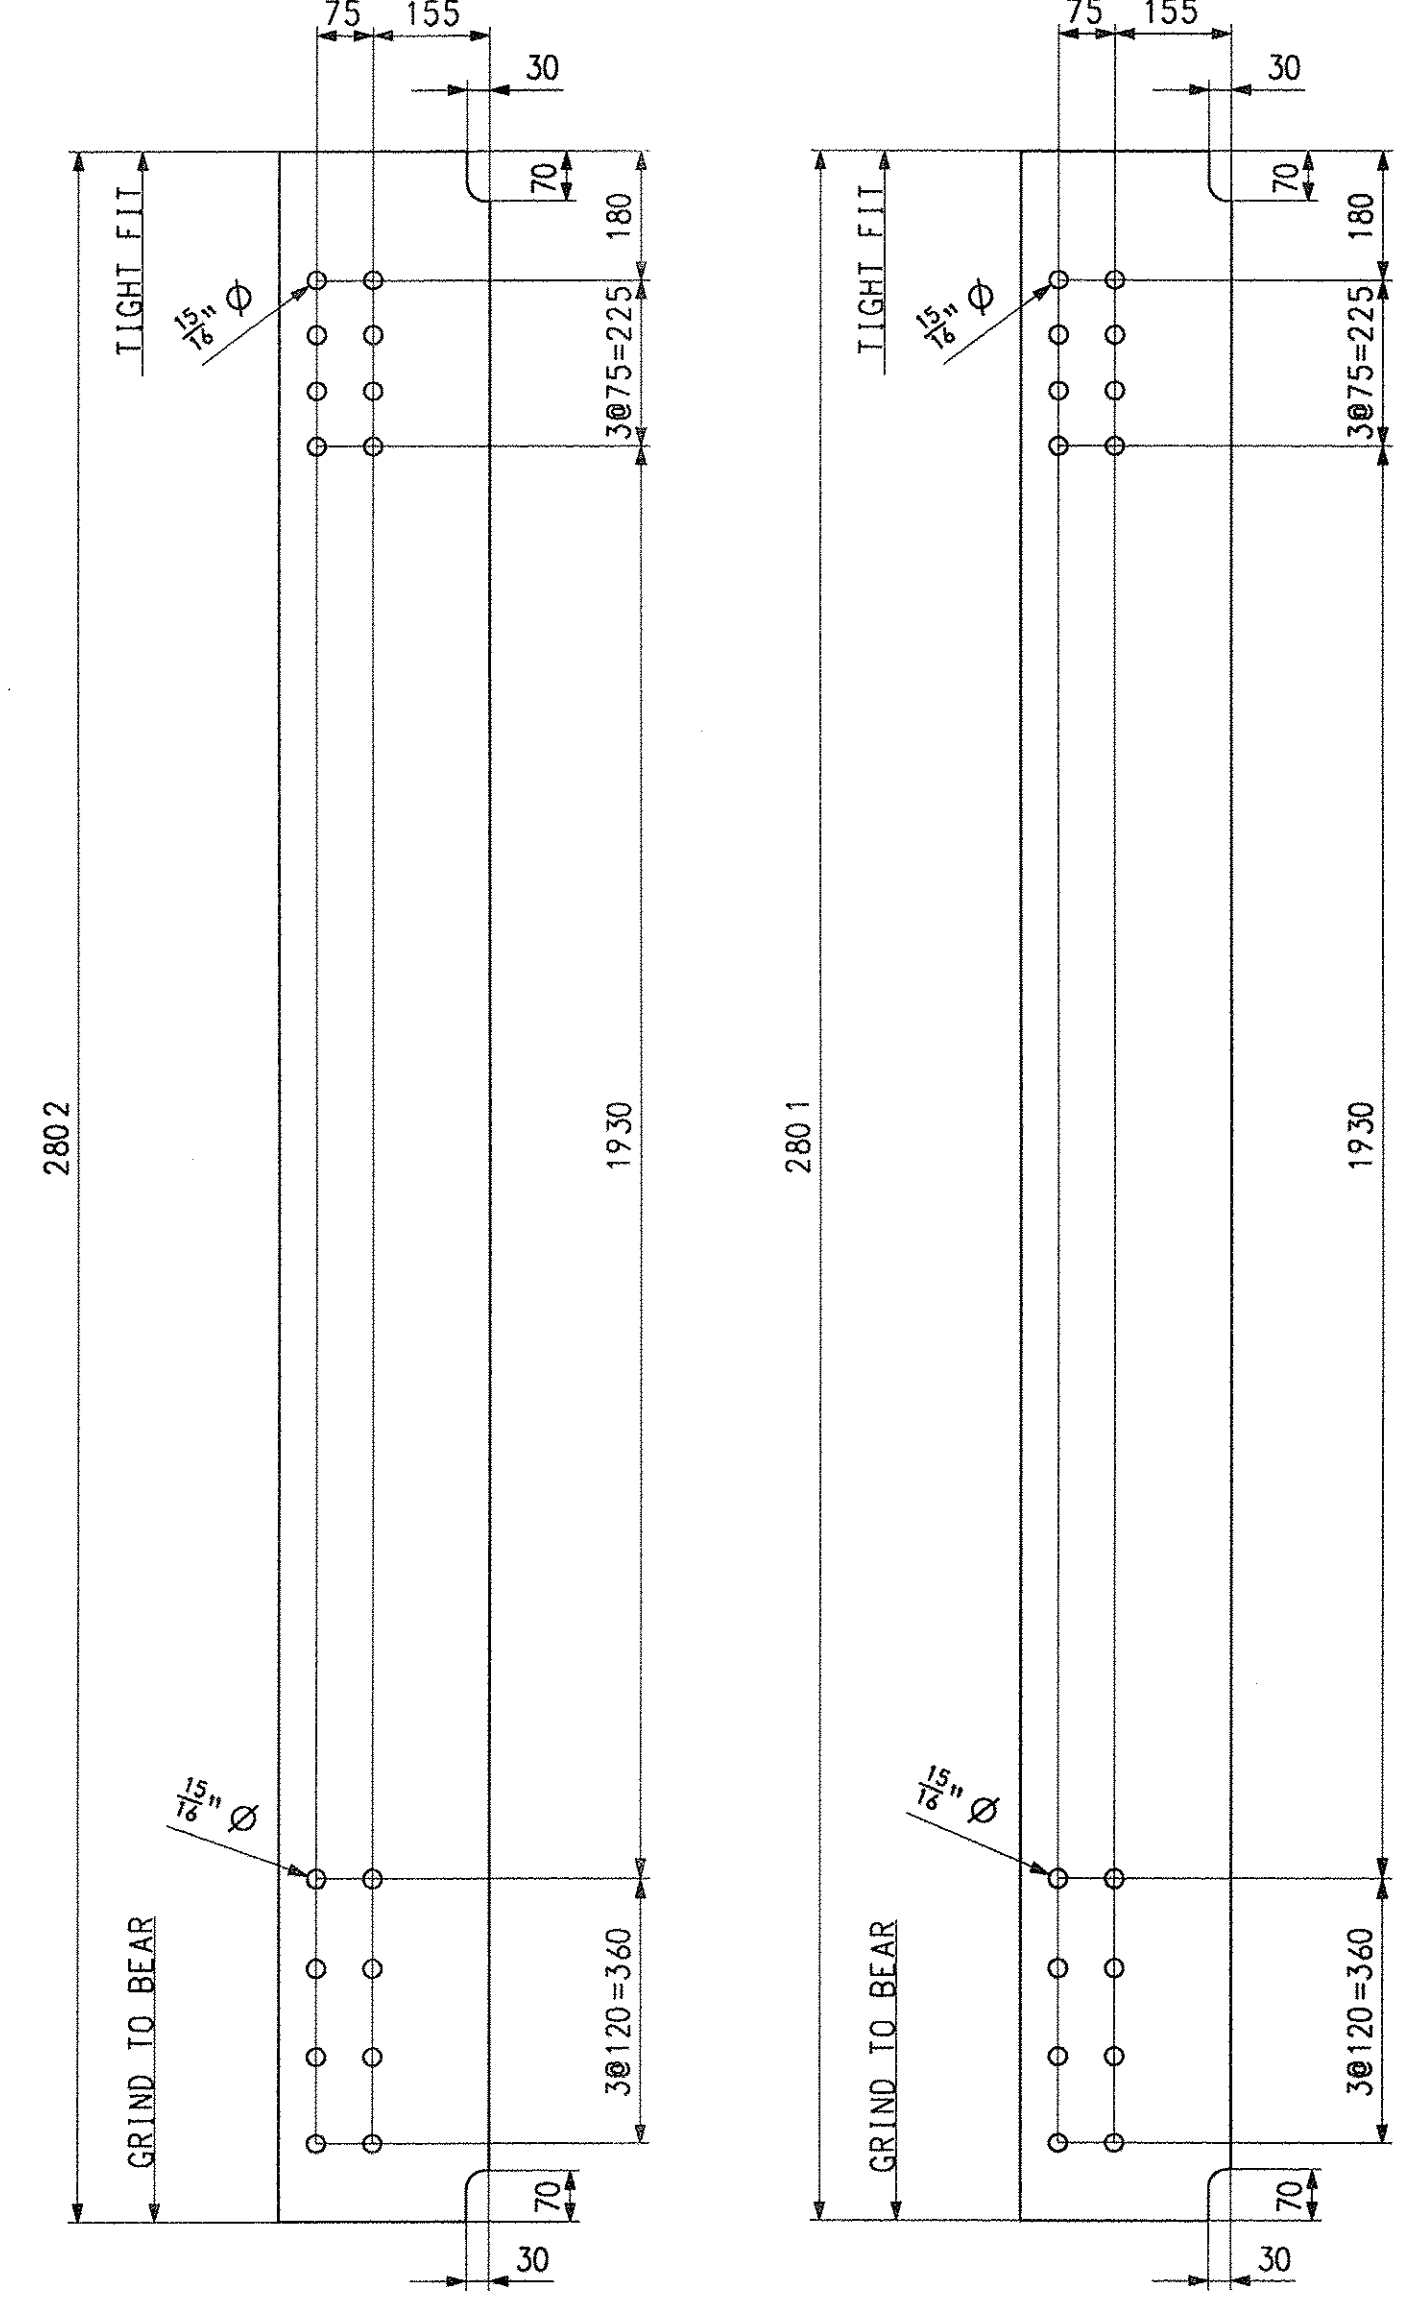


SHIPMENT 1 PMAENG: 500281Z PRD: 500281B SHIP&RECT: 5002819

FLOTTED: 11/30/07 12:48:11 BY: MKreidel

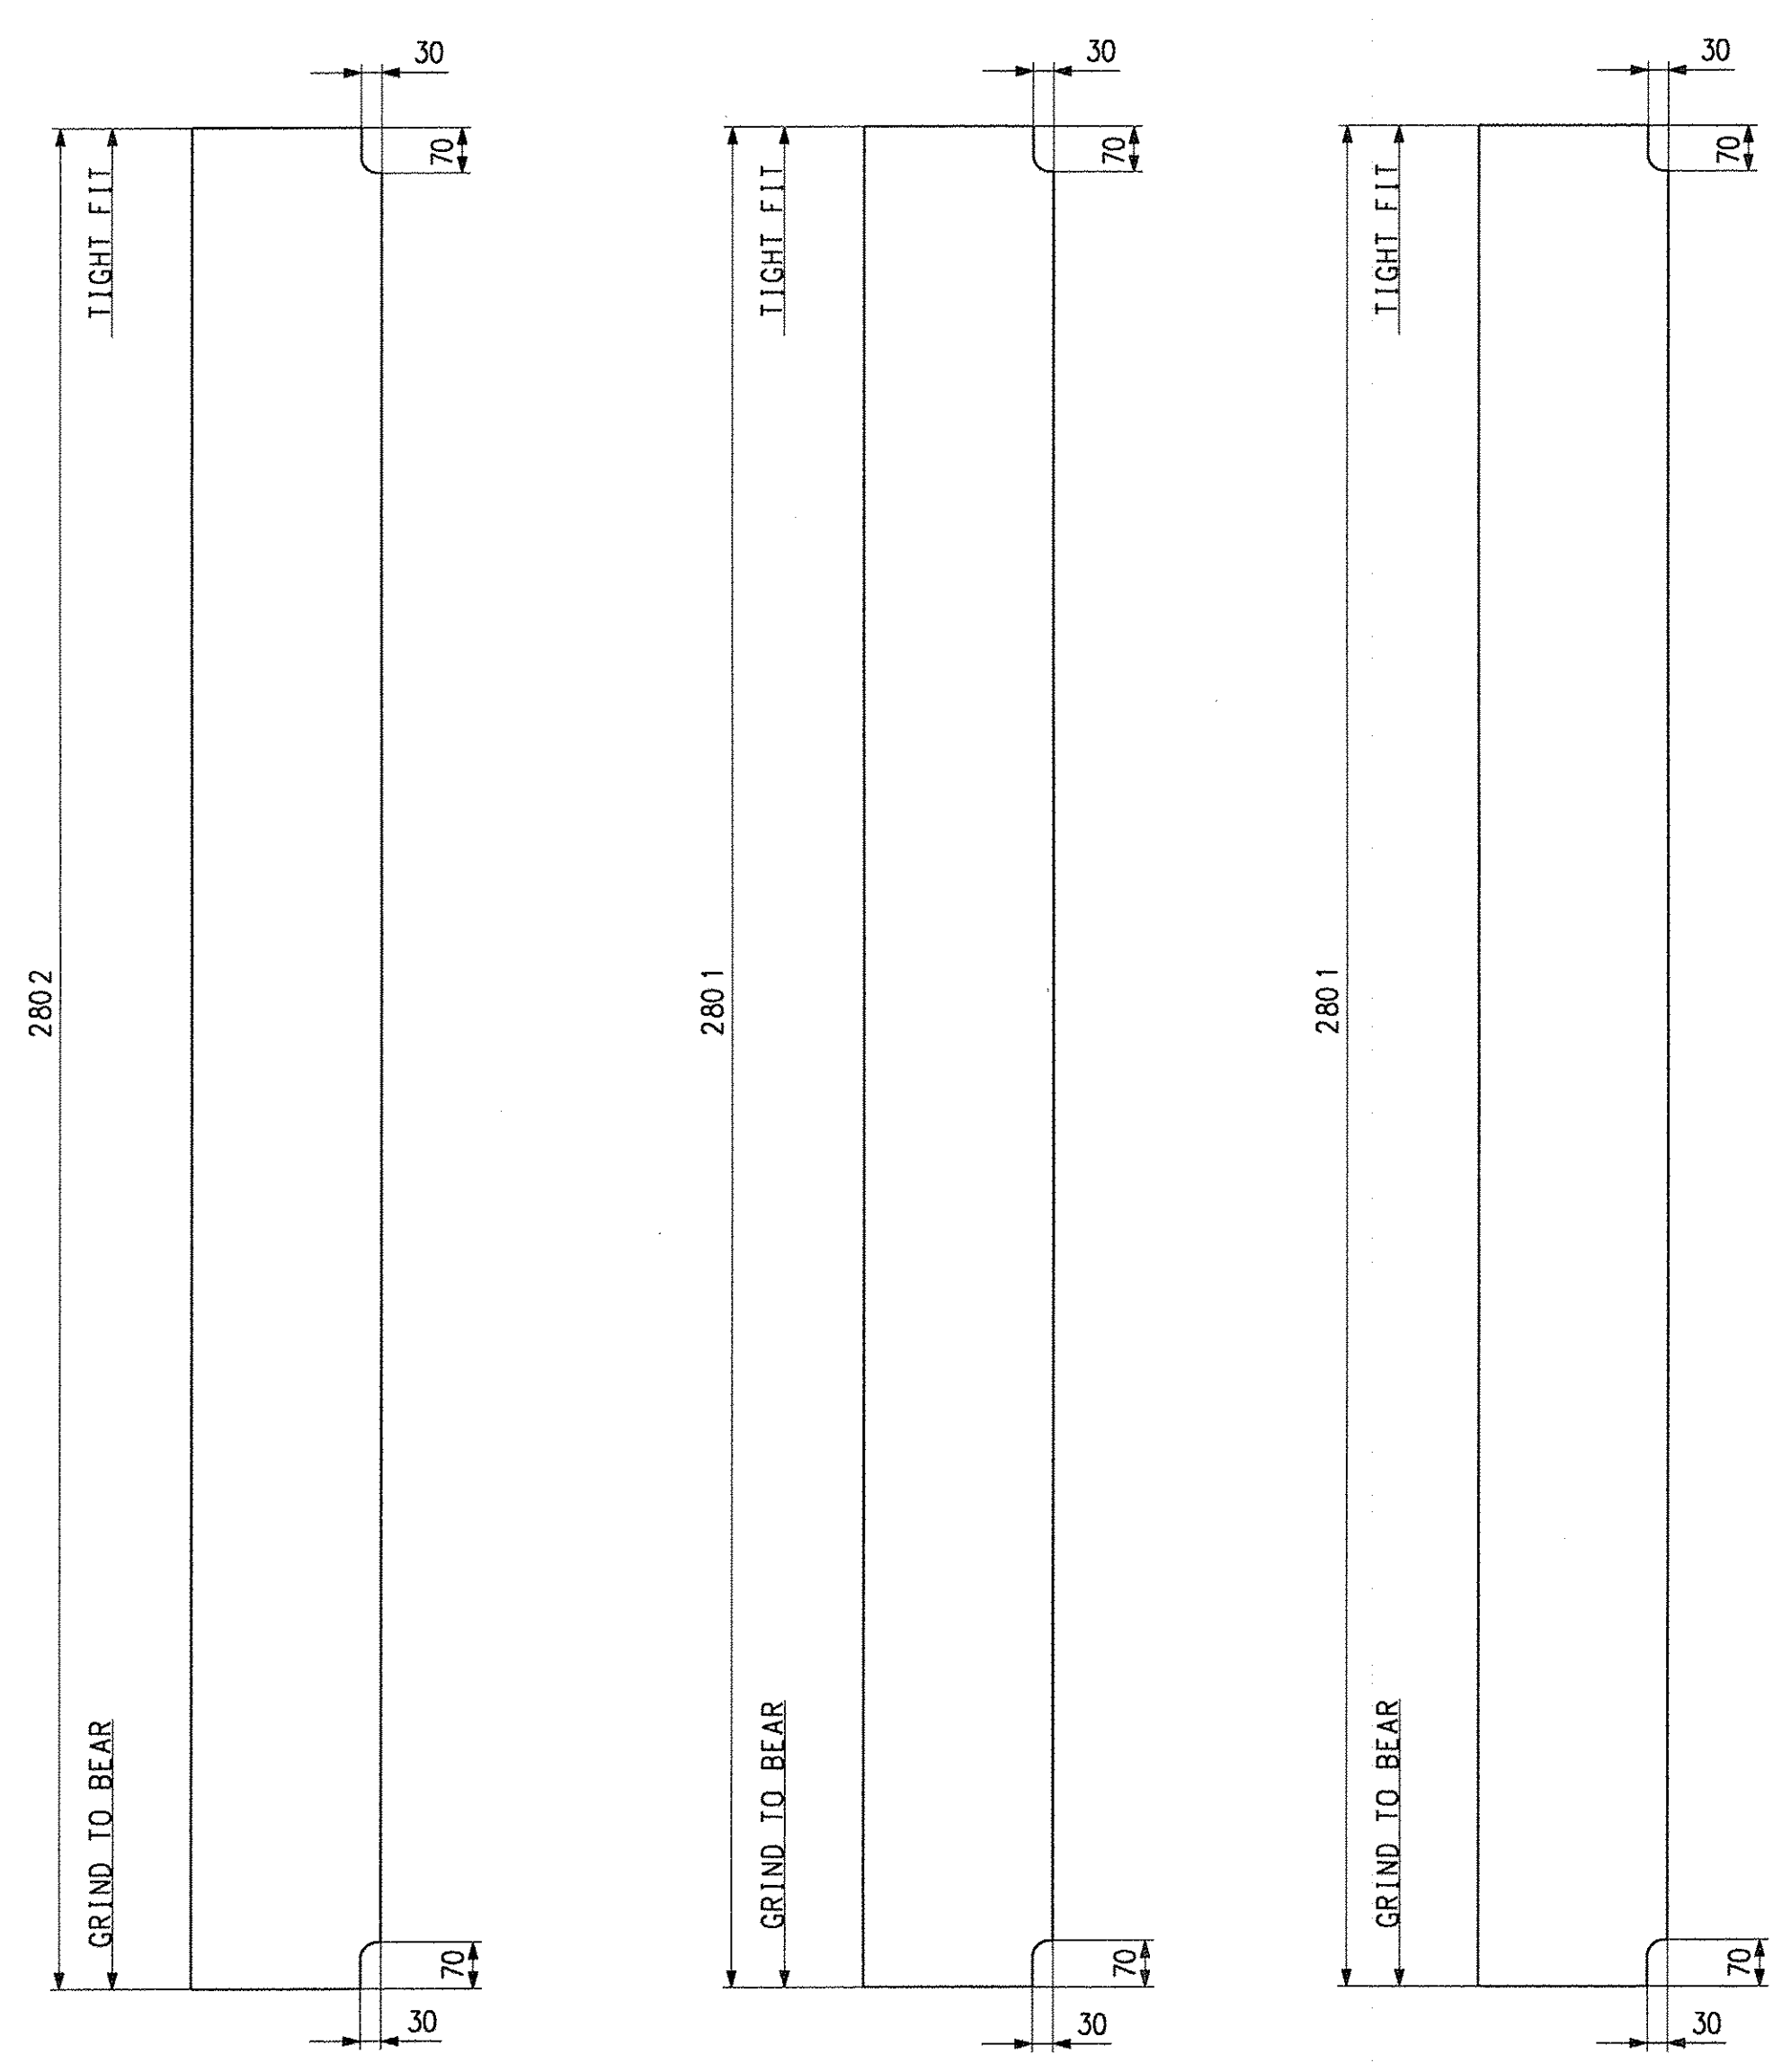

BRG. STIFF. MK. x2a(CG) BRG. STIFF. MK. x2b(CG) BRG. STIFF. MK. x2c BRG. STIFF. MK. x2d(CG) BRG. STIFF. MK. x2f(CG)

BILL OF MATERIAL

QTY	MARK	COMM.	DESCRIPTION	LENGTH	SPEC	GRADE	TEST	REMARKS	ITEM	GROSS WEIGHT EA.	DEDUCTED WEIGHT EA.	NET WEIGHT EA.
14	x2a	PL	25.4 x 280	2802	M270M	345W			07001	156.41	0.00	156.41
14	x2b	PL	25.4 x 280	2801	M270M	345W			07001	156.36	0.00	156.36
14	x2c	PL	25.4 x 280	2801	M270M	345W	T		07001	156.36	0.00	156.36
10	x2d	PL	25.4 x 280	2802	M270M	345W	T		07001	156.41	0.00	156.41
10	x2f	PL	25.4 x 280	2801	M270M	345W	T		07001	156.36	0.00	156.36

TVGA CONSULTANTS

NO EXCEPTIONS TAKEN REJECTED
 FURNISH AS CORRECTED
 REVISE AND RESUBMIT
 ENGINEER has reviewed Shop Drawings and Samples and other data which Contractor is required to submit, only for conformance with the information given in the Contract Documents and compatibility with the design concept of the completed Project as a functioning whole as indicated in the Contract Documents. Such reviews do not extend to means, methods, techniques, sequences or procedures of construction or to safety precautions and programs incident thereto. Contractor is responsible for dimensions to be confirmed and coordinated at the job site, for information that pertains solely to the fabrication processes or to techniques of construction, and for coordination of the work of all trades.
 BY: *[Signature]*
 DATE: 1/26/08

NOTE:
FOR GENERAL SHOP NOTES, SEE DRAWING GN1.

NO.	REVISION	BY	CHK'D	DATE
GIRDER JOB STANDARDS				
VT ROUTE 279 OVER FURNACE BROOK				
VT ROUTE 279 STA. 8+542.000 TO STA. 8+685.000				
TOWN OF BENNINGTON VERMONT, BRIDGE B12				
STATE OF VERMONT				
AGENCY OF TRANSPORTATION				
STATE CONT. OR REF. NO.	AC NH F019-1(53)	FED. AID PROJ. NO.		
SCALE	N.T.S.	GENERAL CONTRACTOR	J. A. McDONALD, INC.	DEB KUPRES
SHIPMT	3	DRAWING MANAGER	BRITIGAN (1H)	MADE BY ERS
STATE	VT	PROJECT NUMBER	S-1070147	HSS1 STRUCT. ID A
				DRK'D. BY CS
				DATE 11-15-07
				DRAWING NUMBER X2 OF X8