


SHIPMENT 1 PWAENG: 500281Z PRD: 500281B SHIPRECT: 5002819


FLOTTED: 11/30/07 12:49:23 BY: MKce1del

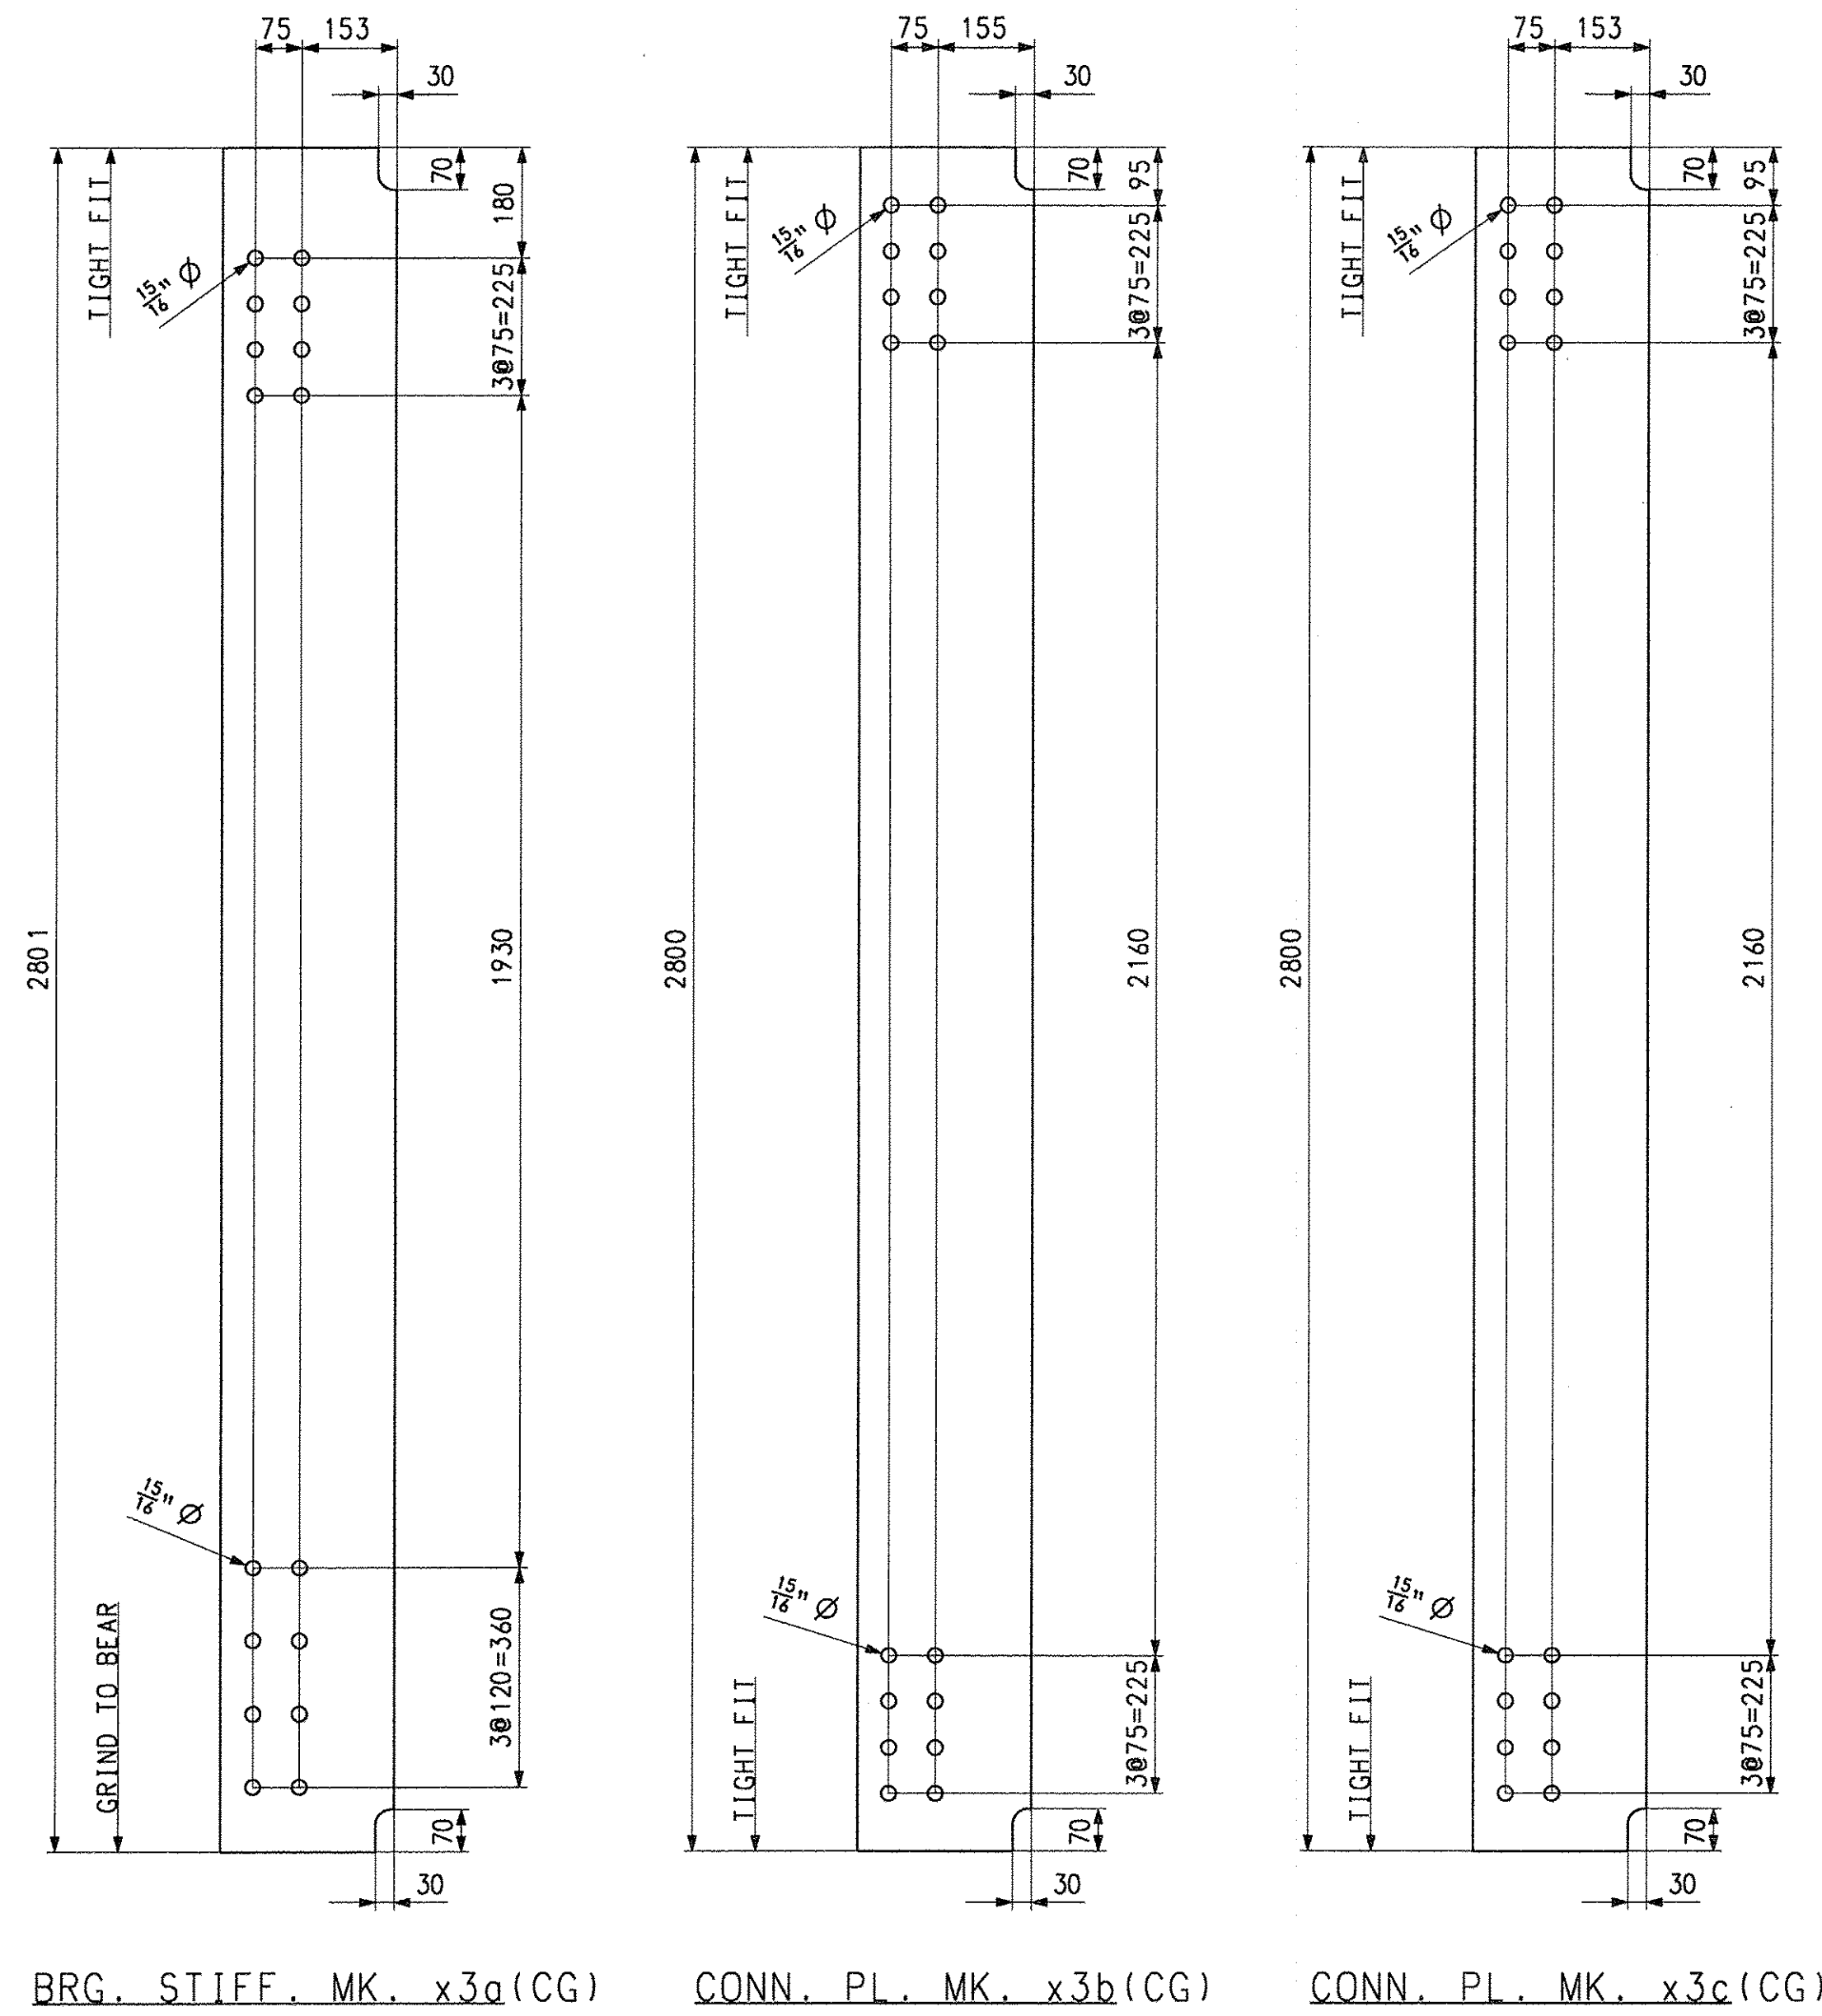


BRG. STIFF. MK. x3a (CG)

CONN. PL. MK. x3b (CG)


CONN. PL. MK. x3c (CG)

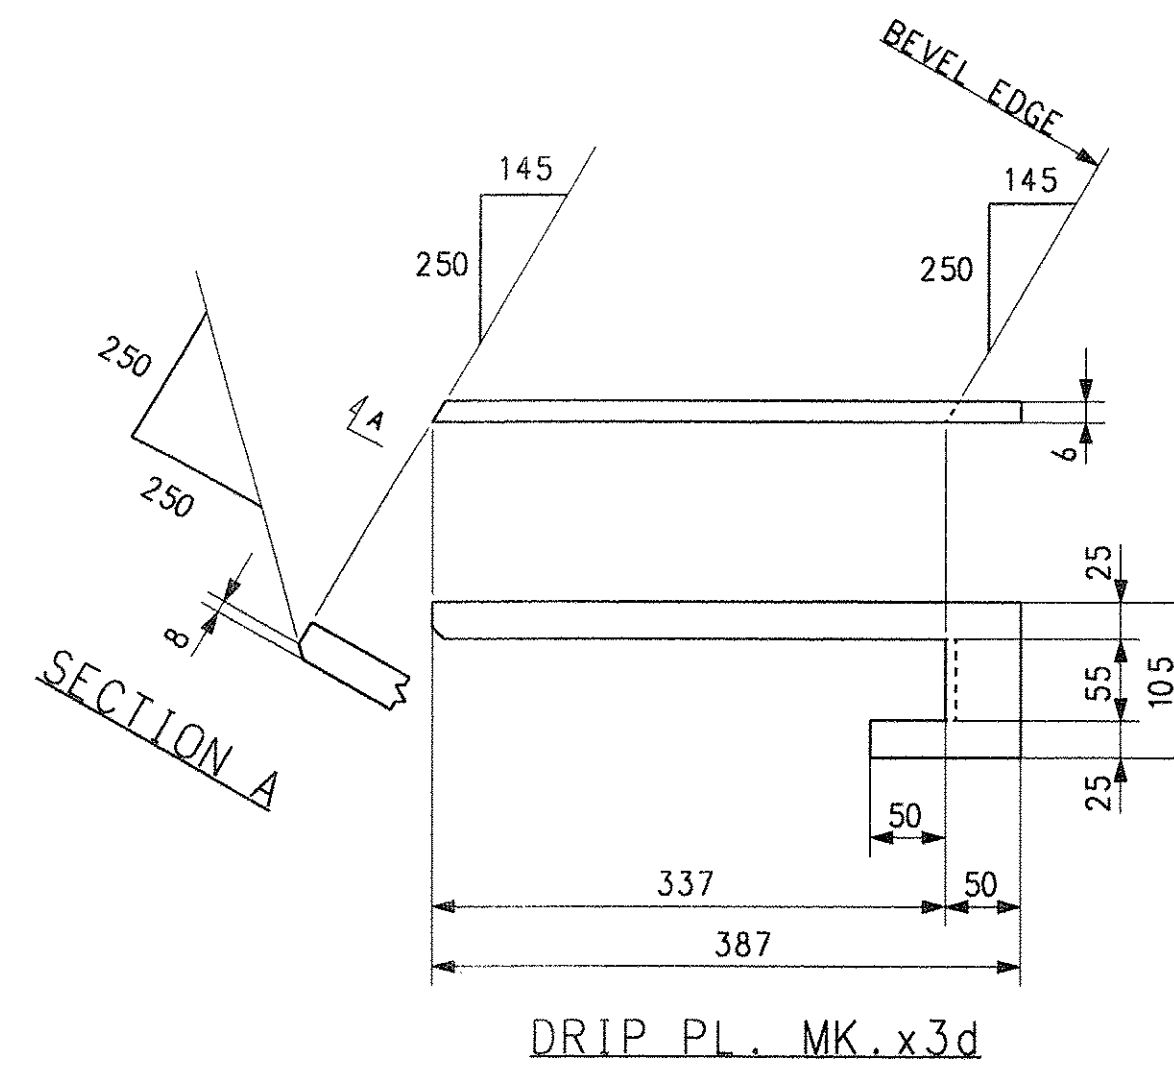


DRIP PL. MK. x3d

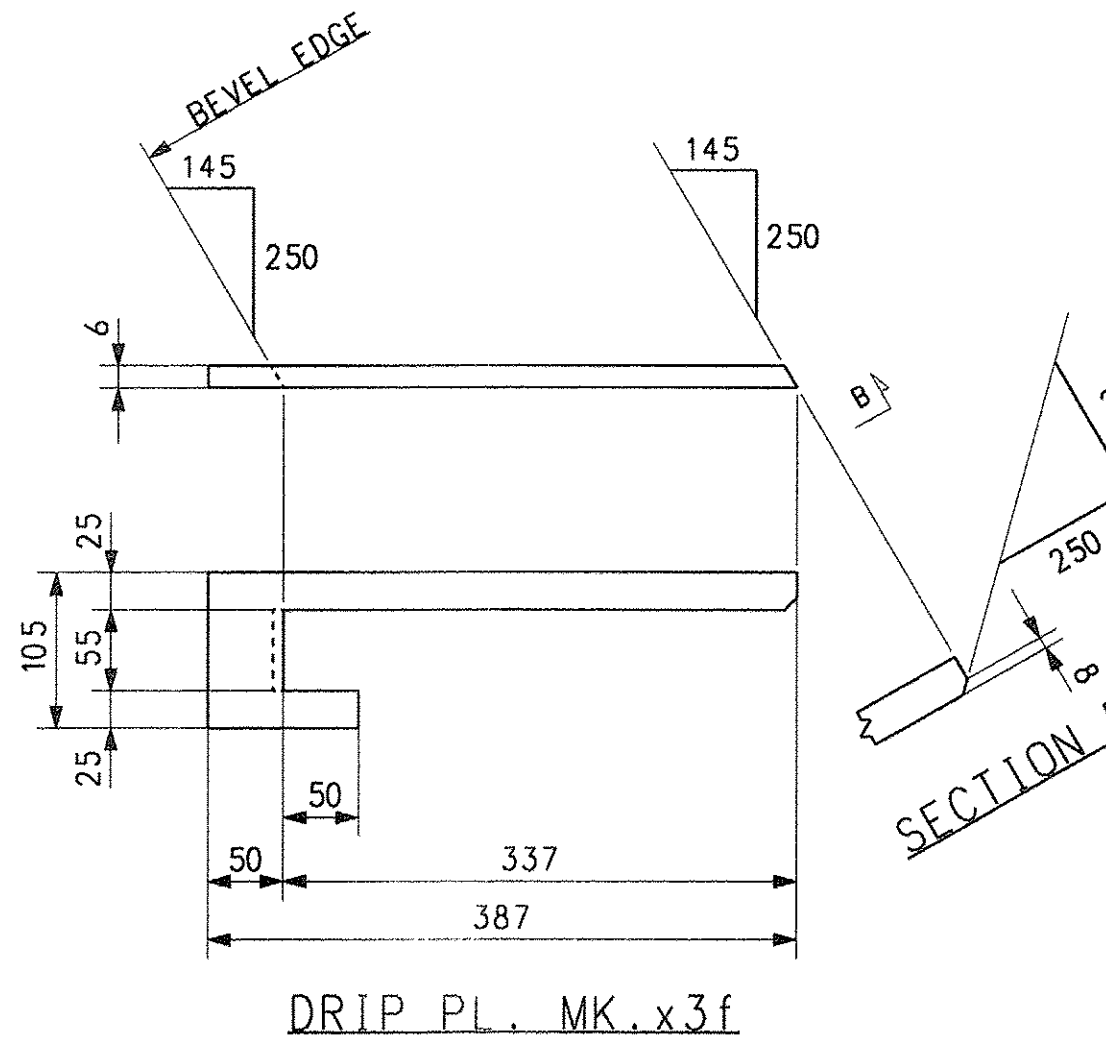

DRIP PL. MK. x3f

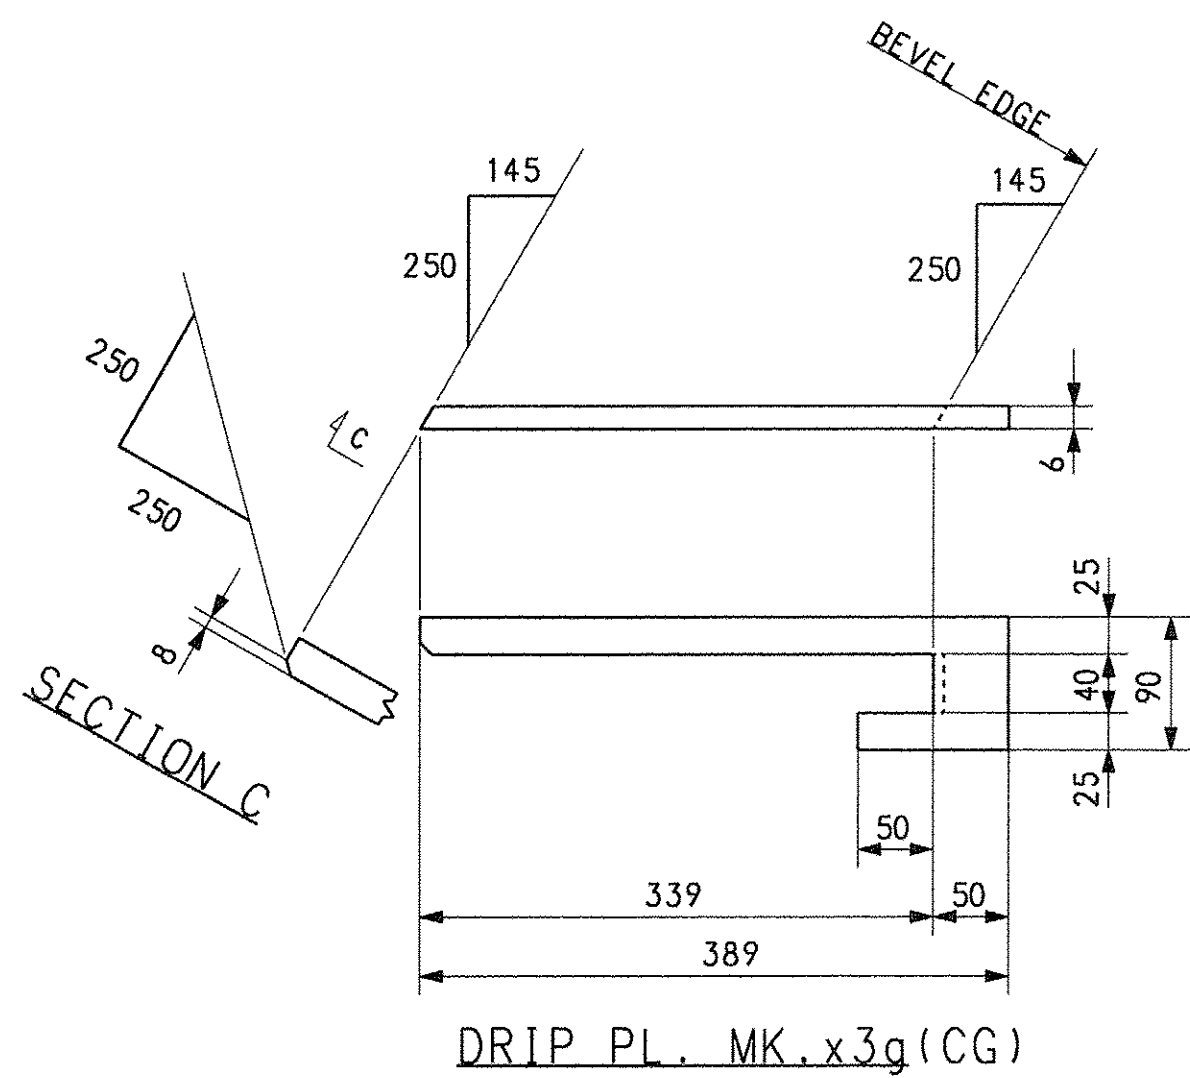

DRIP PL. MK. x3g (CG)

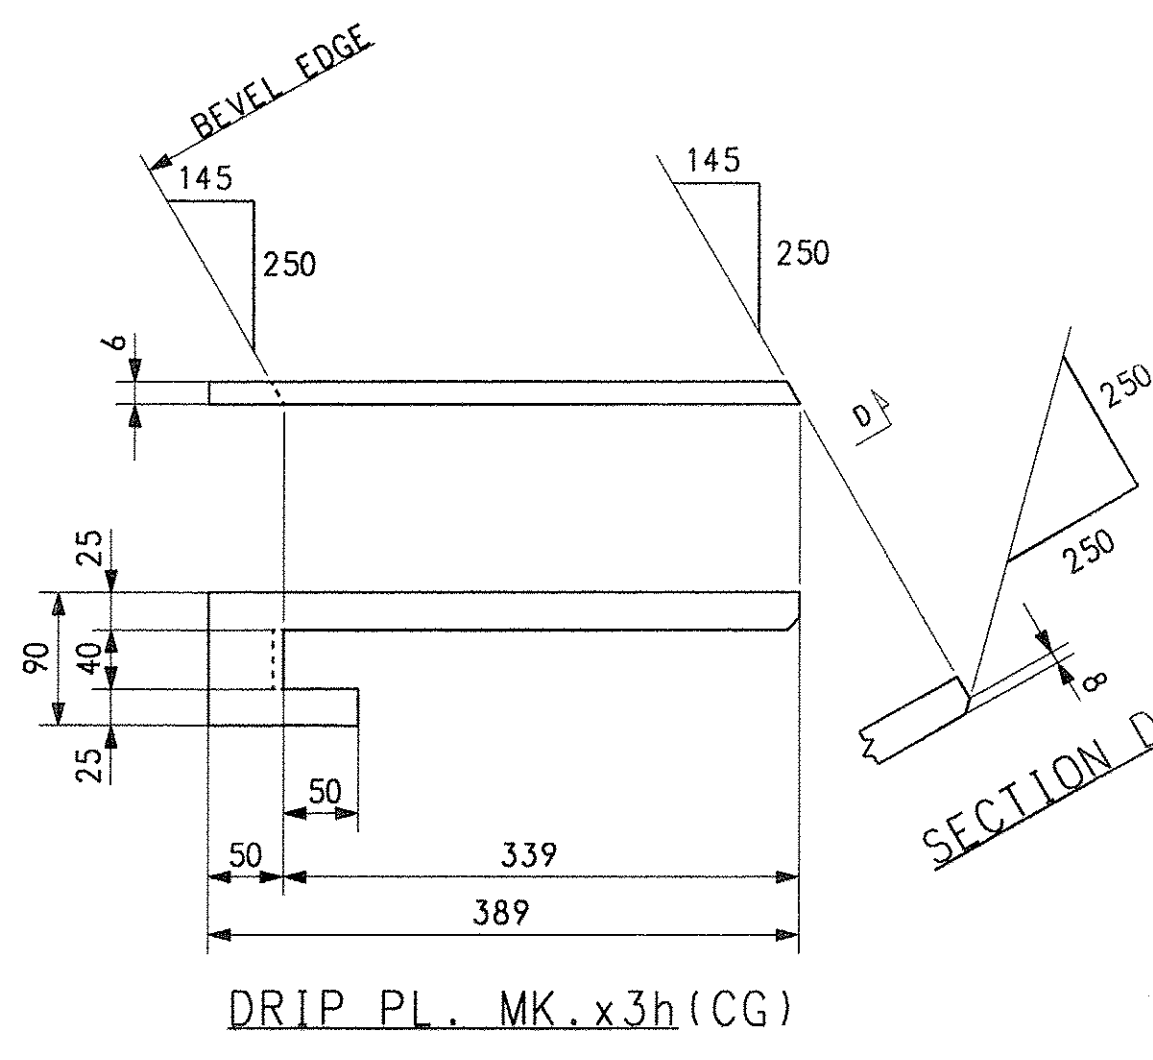

DRIP PL. MK. x3h (CG)

BILL OF MATERIAL

QTY	MARK	COMM.	DESCRIPTION	LENGTH	SPEC	GRADE	TEST	REMARKS	ITEM	GROSS WEIGHT EA.	DEDUCTED WEIGHT EA.	NET WEIGHT EA.
10	x3a	PL	25.4 x 280	2801	M270M	345W	T		07001	156.36	0.00	156.36
200	x3b	PL	14.3 x 280	2800	M270M	345W	T		07002	88.00	0.00	88.00
80	x3c	PL	15.9 x 280	2800	M270M	345W	T		07006	97.84	0.00	97.84
1	x3d	PL	6.4 x 105	387	M270M	345W			07004	2.04	0.00	2.04
1	x3e	PL	6.4 x 105	387	M270M	345W			07004	2.04	0.00	2.04
1	x3g	PL	6.4 x 90	389	M270M	345W			07005	1.76	0.00	1.76
1	x3h	PL	6.4 x 90	389	M270M	345W			07005	1.76	0.00	1.76

TVGA CONSULTANTS

NO EXCEPTIONS TAKEN  REJECTED  
 FURNISH AS CORRECTED  
 REVISE AND RESUBMIT  
 ENGINEER has reviewed Shop Drawings and Samples and other data which Contractor is required to submit, only for performance with the information given in the Contract Documents and compliance with the design concept of the completed Project as a functioning whole as indicated in the Contract Documents. Such reviews do not extend to means, methods, techniques, sequences or procedures of construction or to safety precautions and programs incident thereto. Contractor is responsible for dimensions to be confirmed and controlled at the job site; for information that pertains solely to the fabrication processes or to techniques of construction; and for coordination of the work of all trades.  
 BY: *abed*  
 DATE: 11/28/07

NOTE:  
FOR GENERAL SHOP NOTES, SEE DRAWING GN1.

NO.	REVISION	BY	CHK'D	DATE	
GIRDER JOB STANDARDS					
VT ROUTE 279 OVER FURNACE BROOK					
VT ROUTE 279 STA. 8+542.000 TO STA. 8+685.000					
TOWN OF BENNINGTON VERMONT, BRIDGE B12					
STATE OF VERMONT					
AGENCY OF TRANSPORTATION					
STATE CONT. OR REF. NO.	AC NH F019-1153	FED. AID PROJ. NO.			
SCALE	N.T.S.	GENERAL CONTRACTOR	J.A. McDONALD, INC.	DEB KUPRES	
SHRIMP	3	DRAWING MANAGER	BRITIGAN (IH)	MADE BY ERS	
STATE	VT	HSSI PROJECT NUMBER	S-1070147	HSSI STRUCT. ID A	
				DATE	11-15-07
				DRAWING NUMBER	X3 OF X8