


METRIC

TVGA CONSULTANTS






NO EXCEPTIONS TAKEN REJECTED
FURNISH AS CORRECTED
REVISE AND RESUBMIT
ENGINEER has reviewed Shop Drawings and Samples and other data which Contractor is required to submit...

BY: [Signature]
DATE: 6/19/08

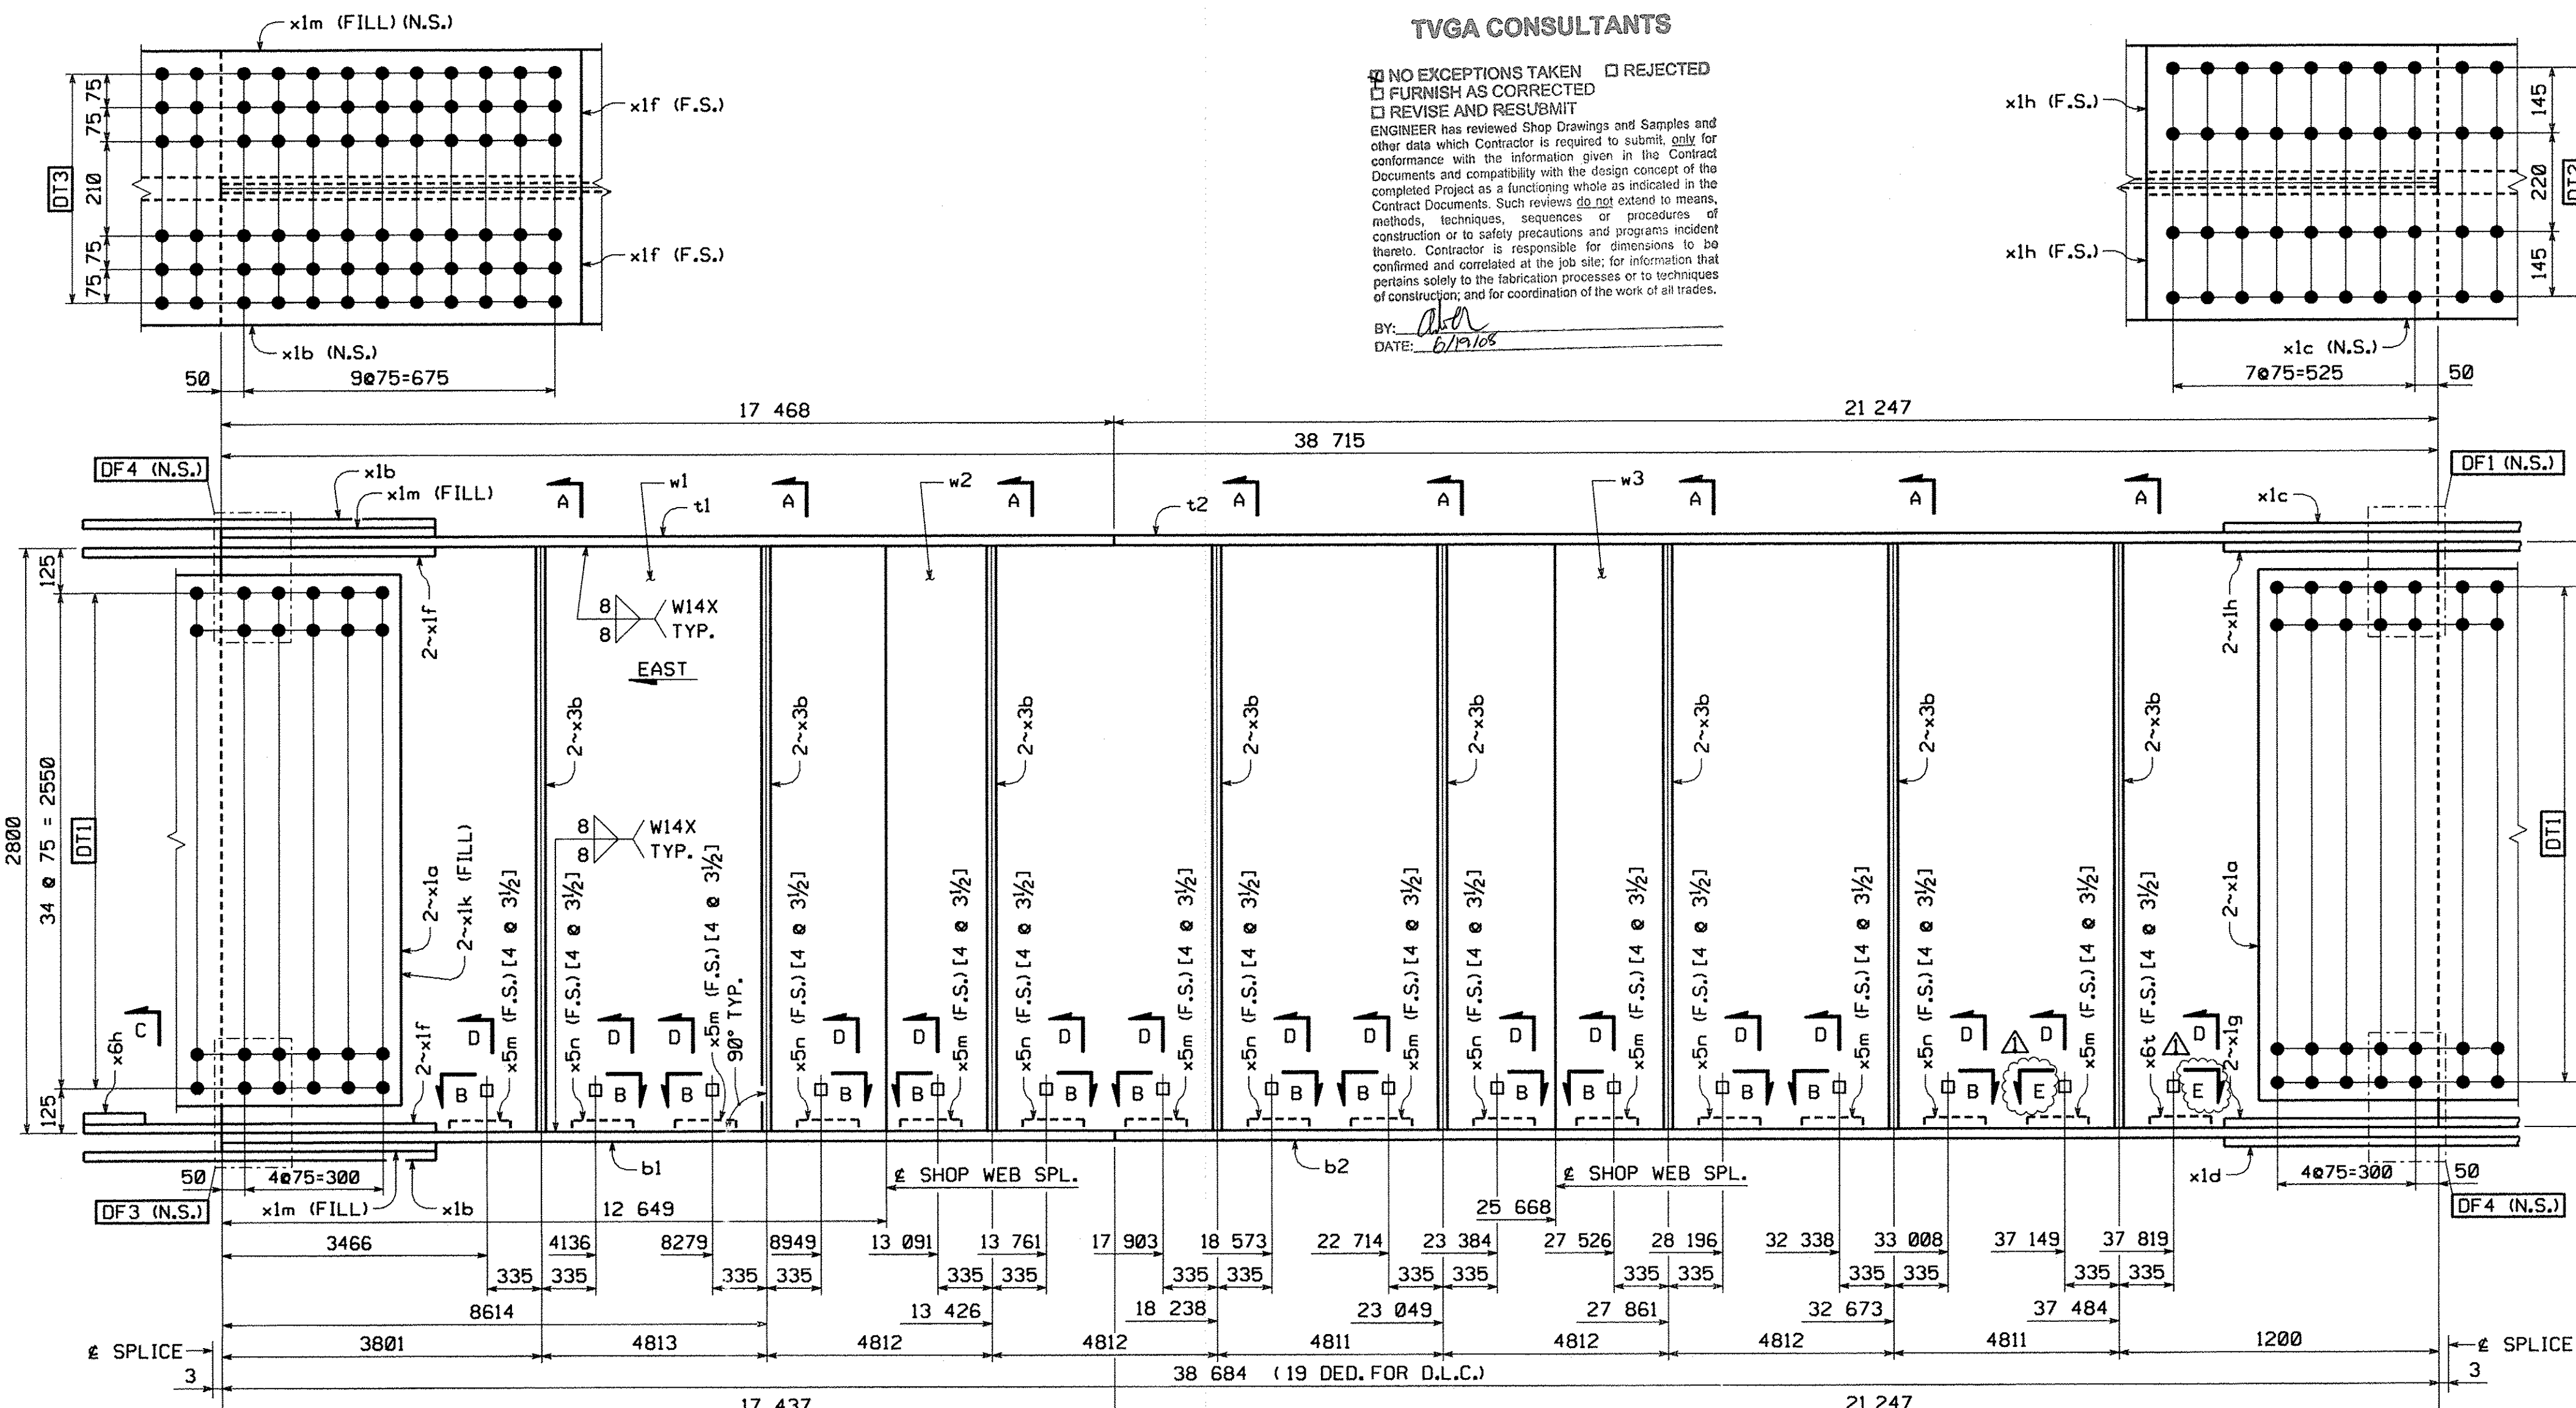

BILL OF MATERIAL table with columns: QTY, MARK, COMM, DESCRIPTION, LENGTH, SPEC, GRADE, TEST, REMARKS, ITEM, GROSS WT. EA, DEEL WEIGHT, NET WT. EA. Includes items like G4D, PL, SHIT, HS Bolt, NLI, W4 Slid Wash.

TOTAL WEIGHT THIS SHEET: 37 512.69 kgs
BID ITEM 0160 506.56

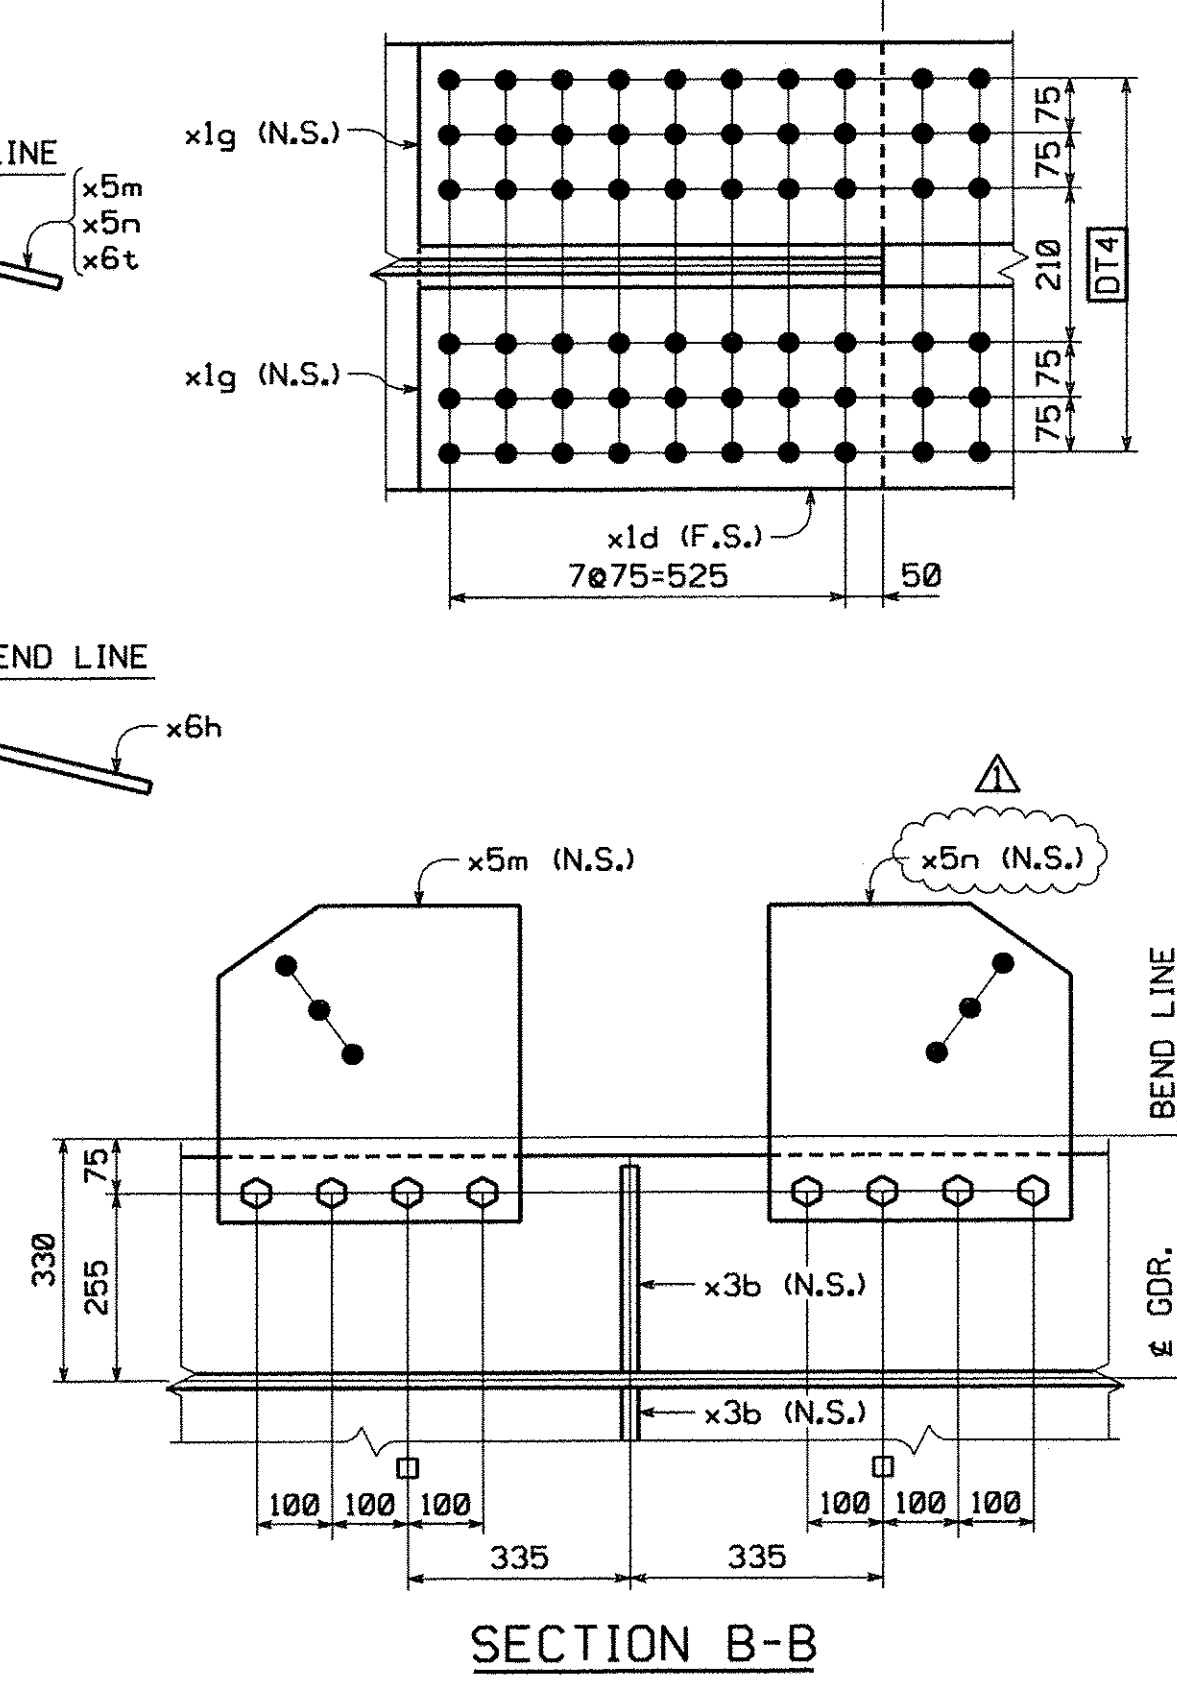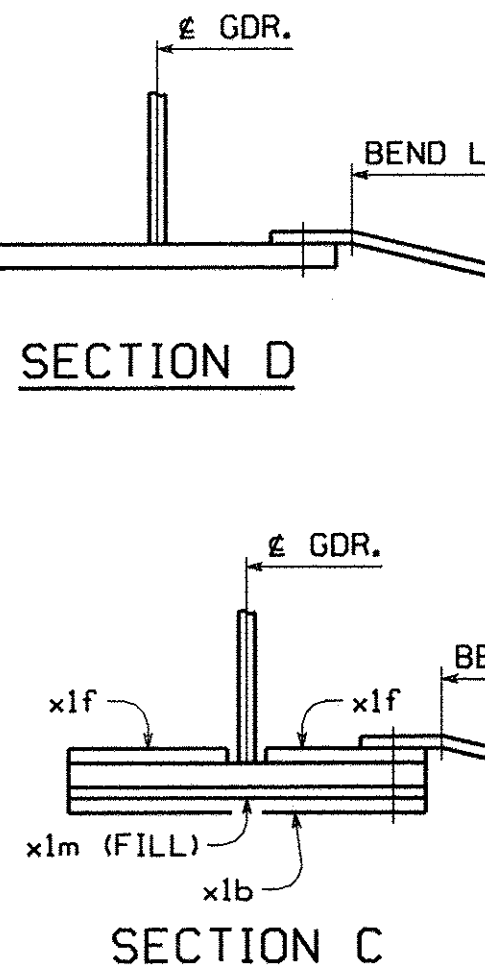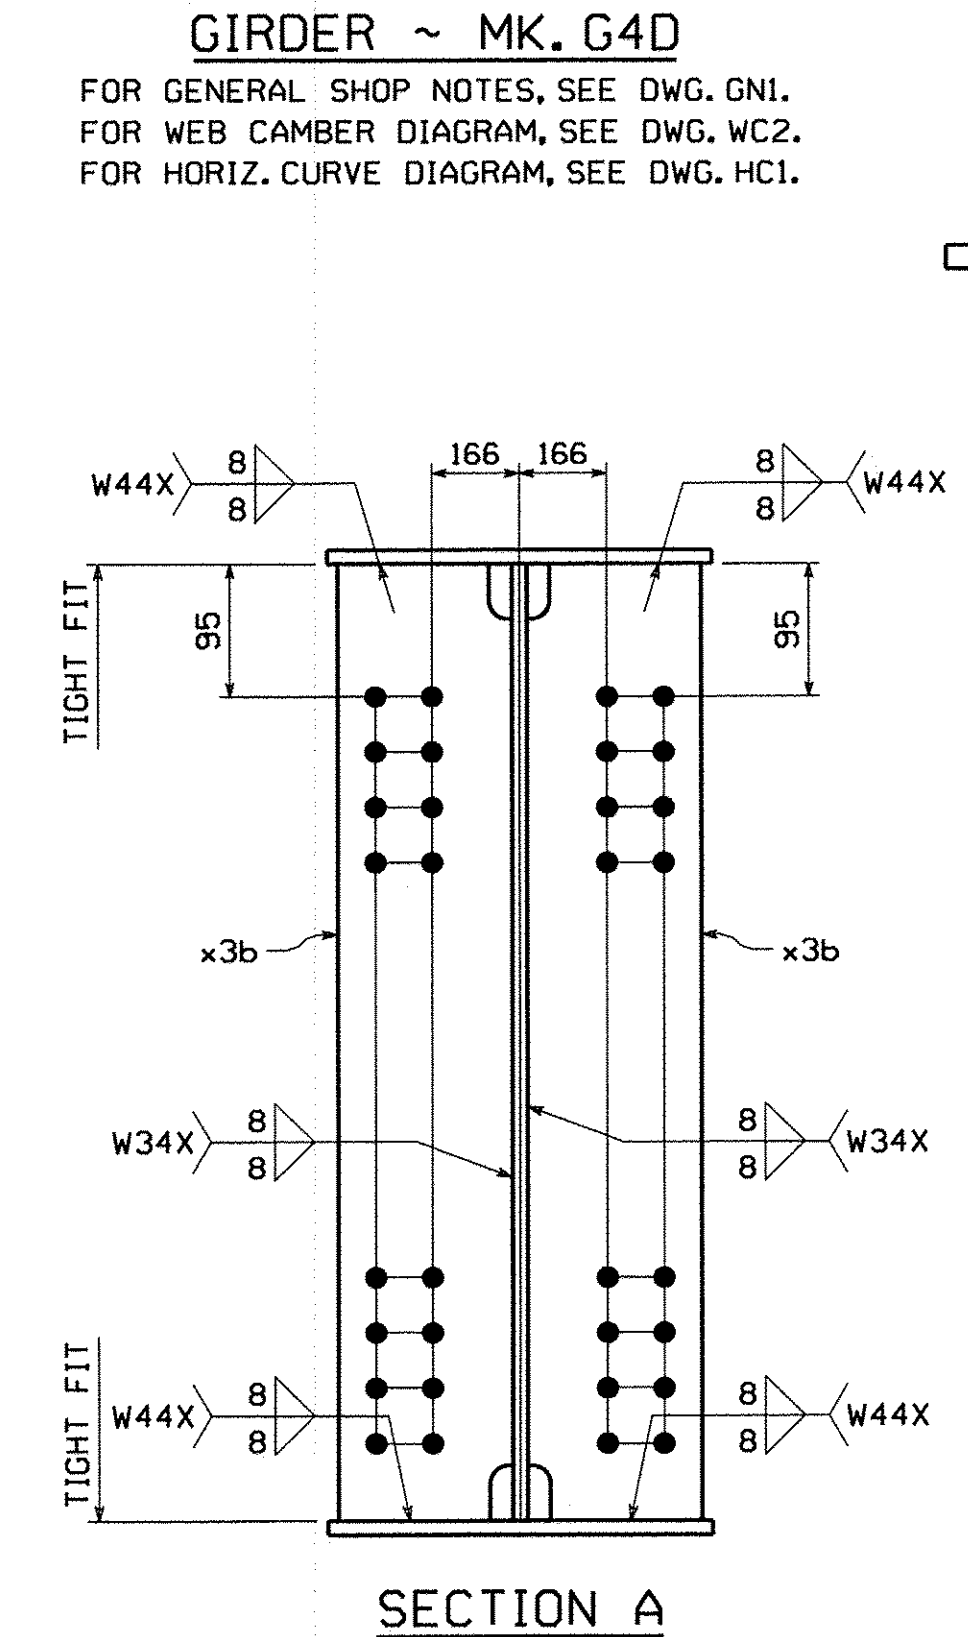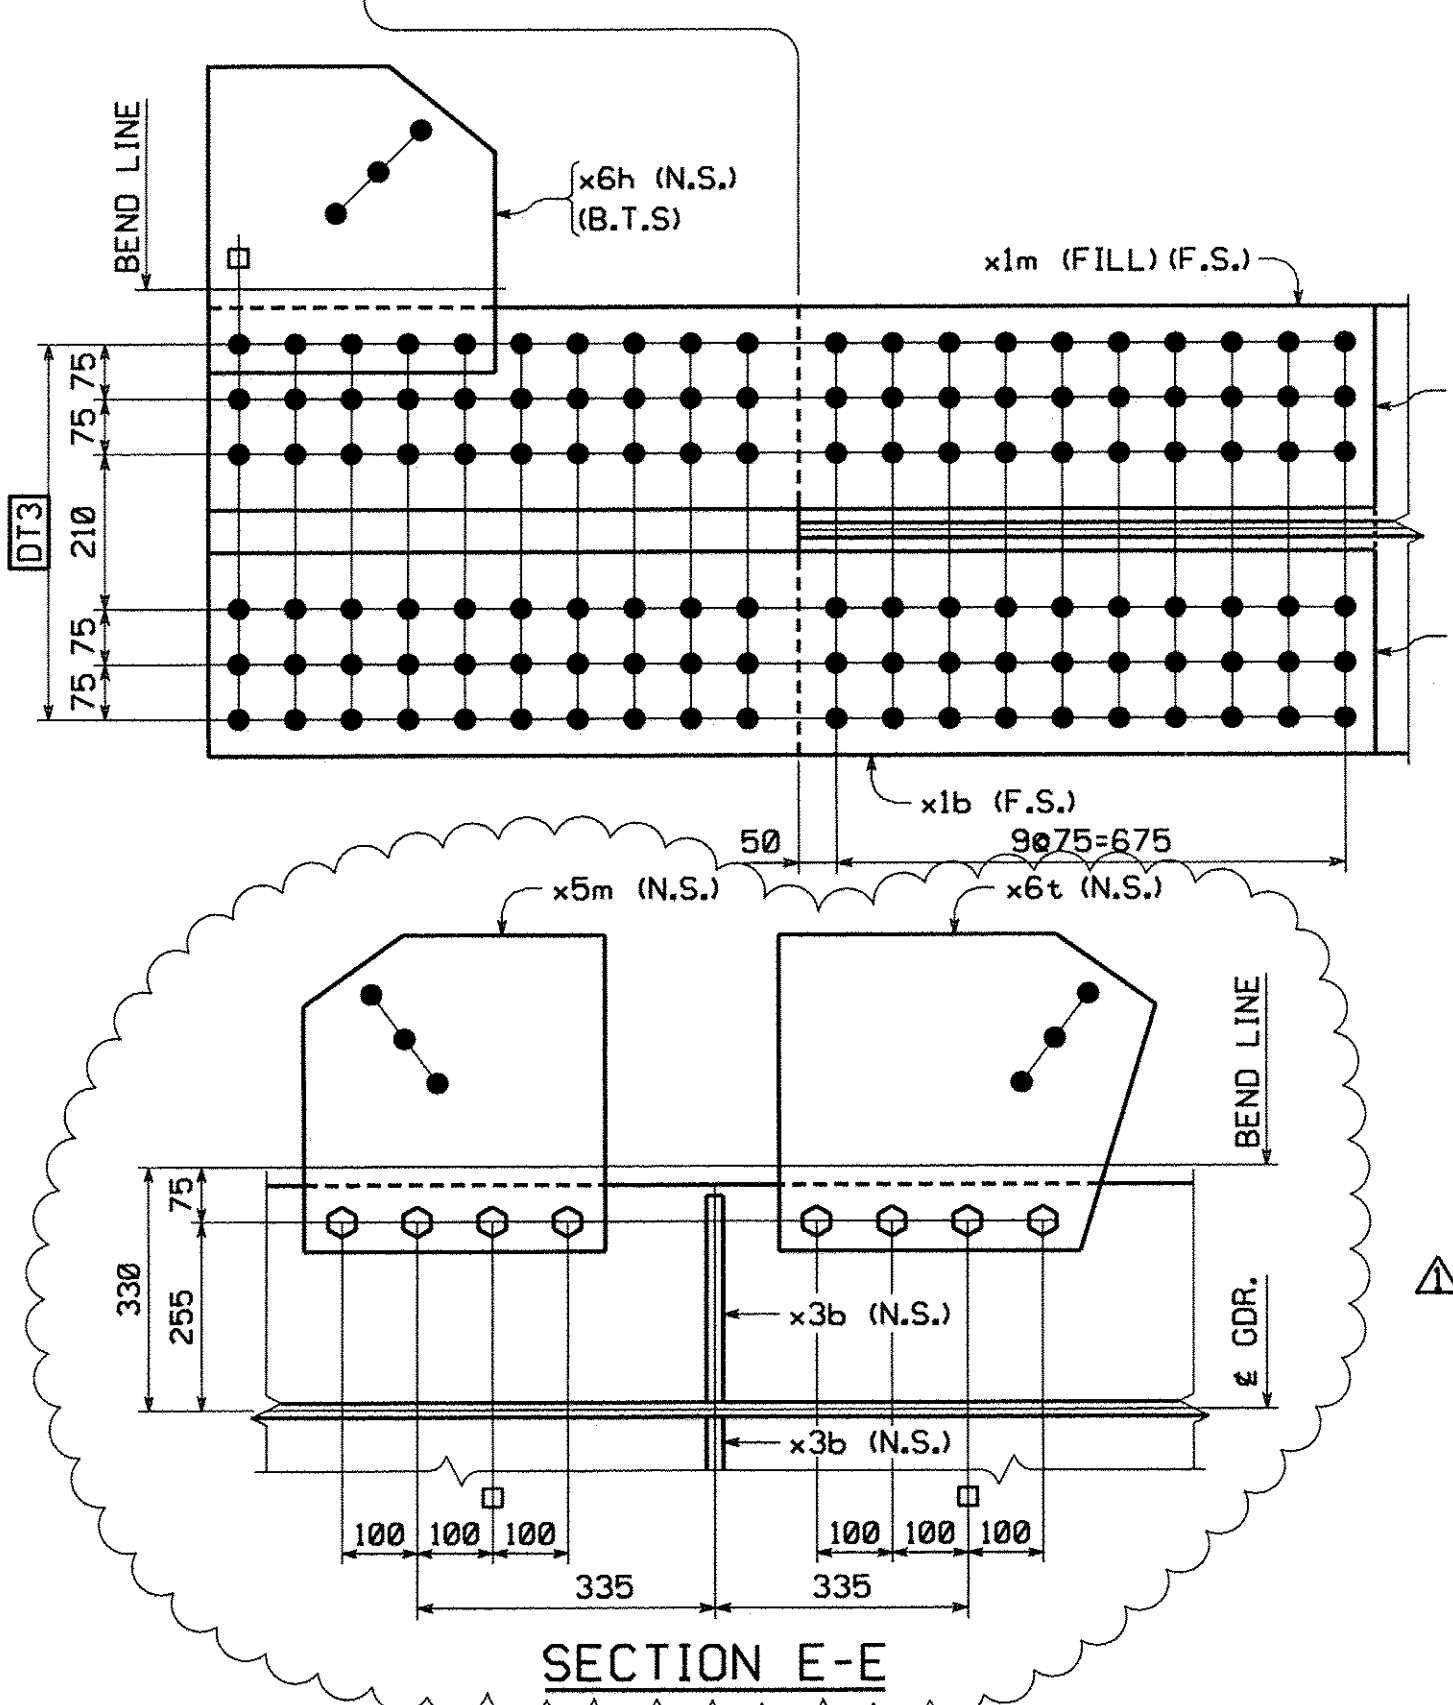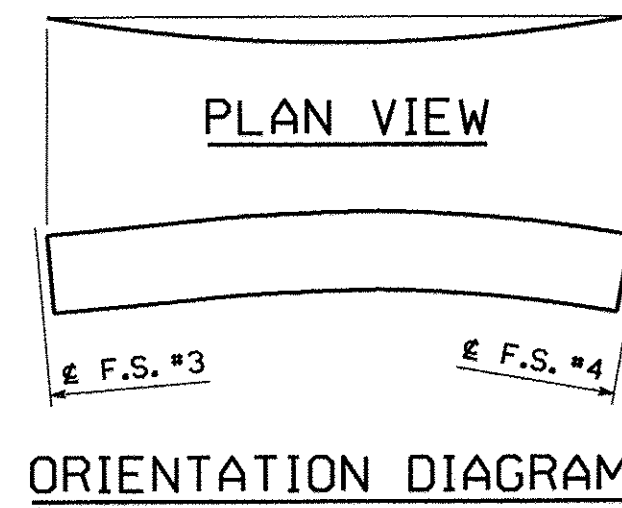

GIRDER ~ MK. G4D
FOR GENERAL SHOP NOTES, SEE DWG. GNI.
FOR WEB CAMBER DIAGRAM, SEE DWG. WC2.
FOR HORIZ. CURVE DIAGRAM, SEE DWG. HCI.

Revision table and project information including: Holes, Bolts, AS NOTED, COATING, CODE(S), SCALE, SHPMNT, STATE, and project details like BRITIGAN (IH), BRITIGAN (IH), S-1070147, DATE 11/27/07.

SHIPPING 01 PHASENO: 50023017 PROD: 50023018 SHIPPERECT: 50023019
BY: Mckevide
PLOTTER: 5/29/2008 10:07:30 AM