


SHIPMENT 1 PAKENG: 500281BZ PRD: 500281B SHIP&RECT: 500281G

PLOTTED: 11/30/07 12:51:39 BY: MKreidel

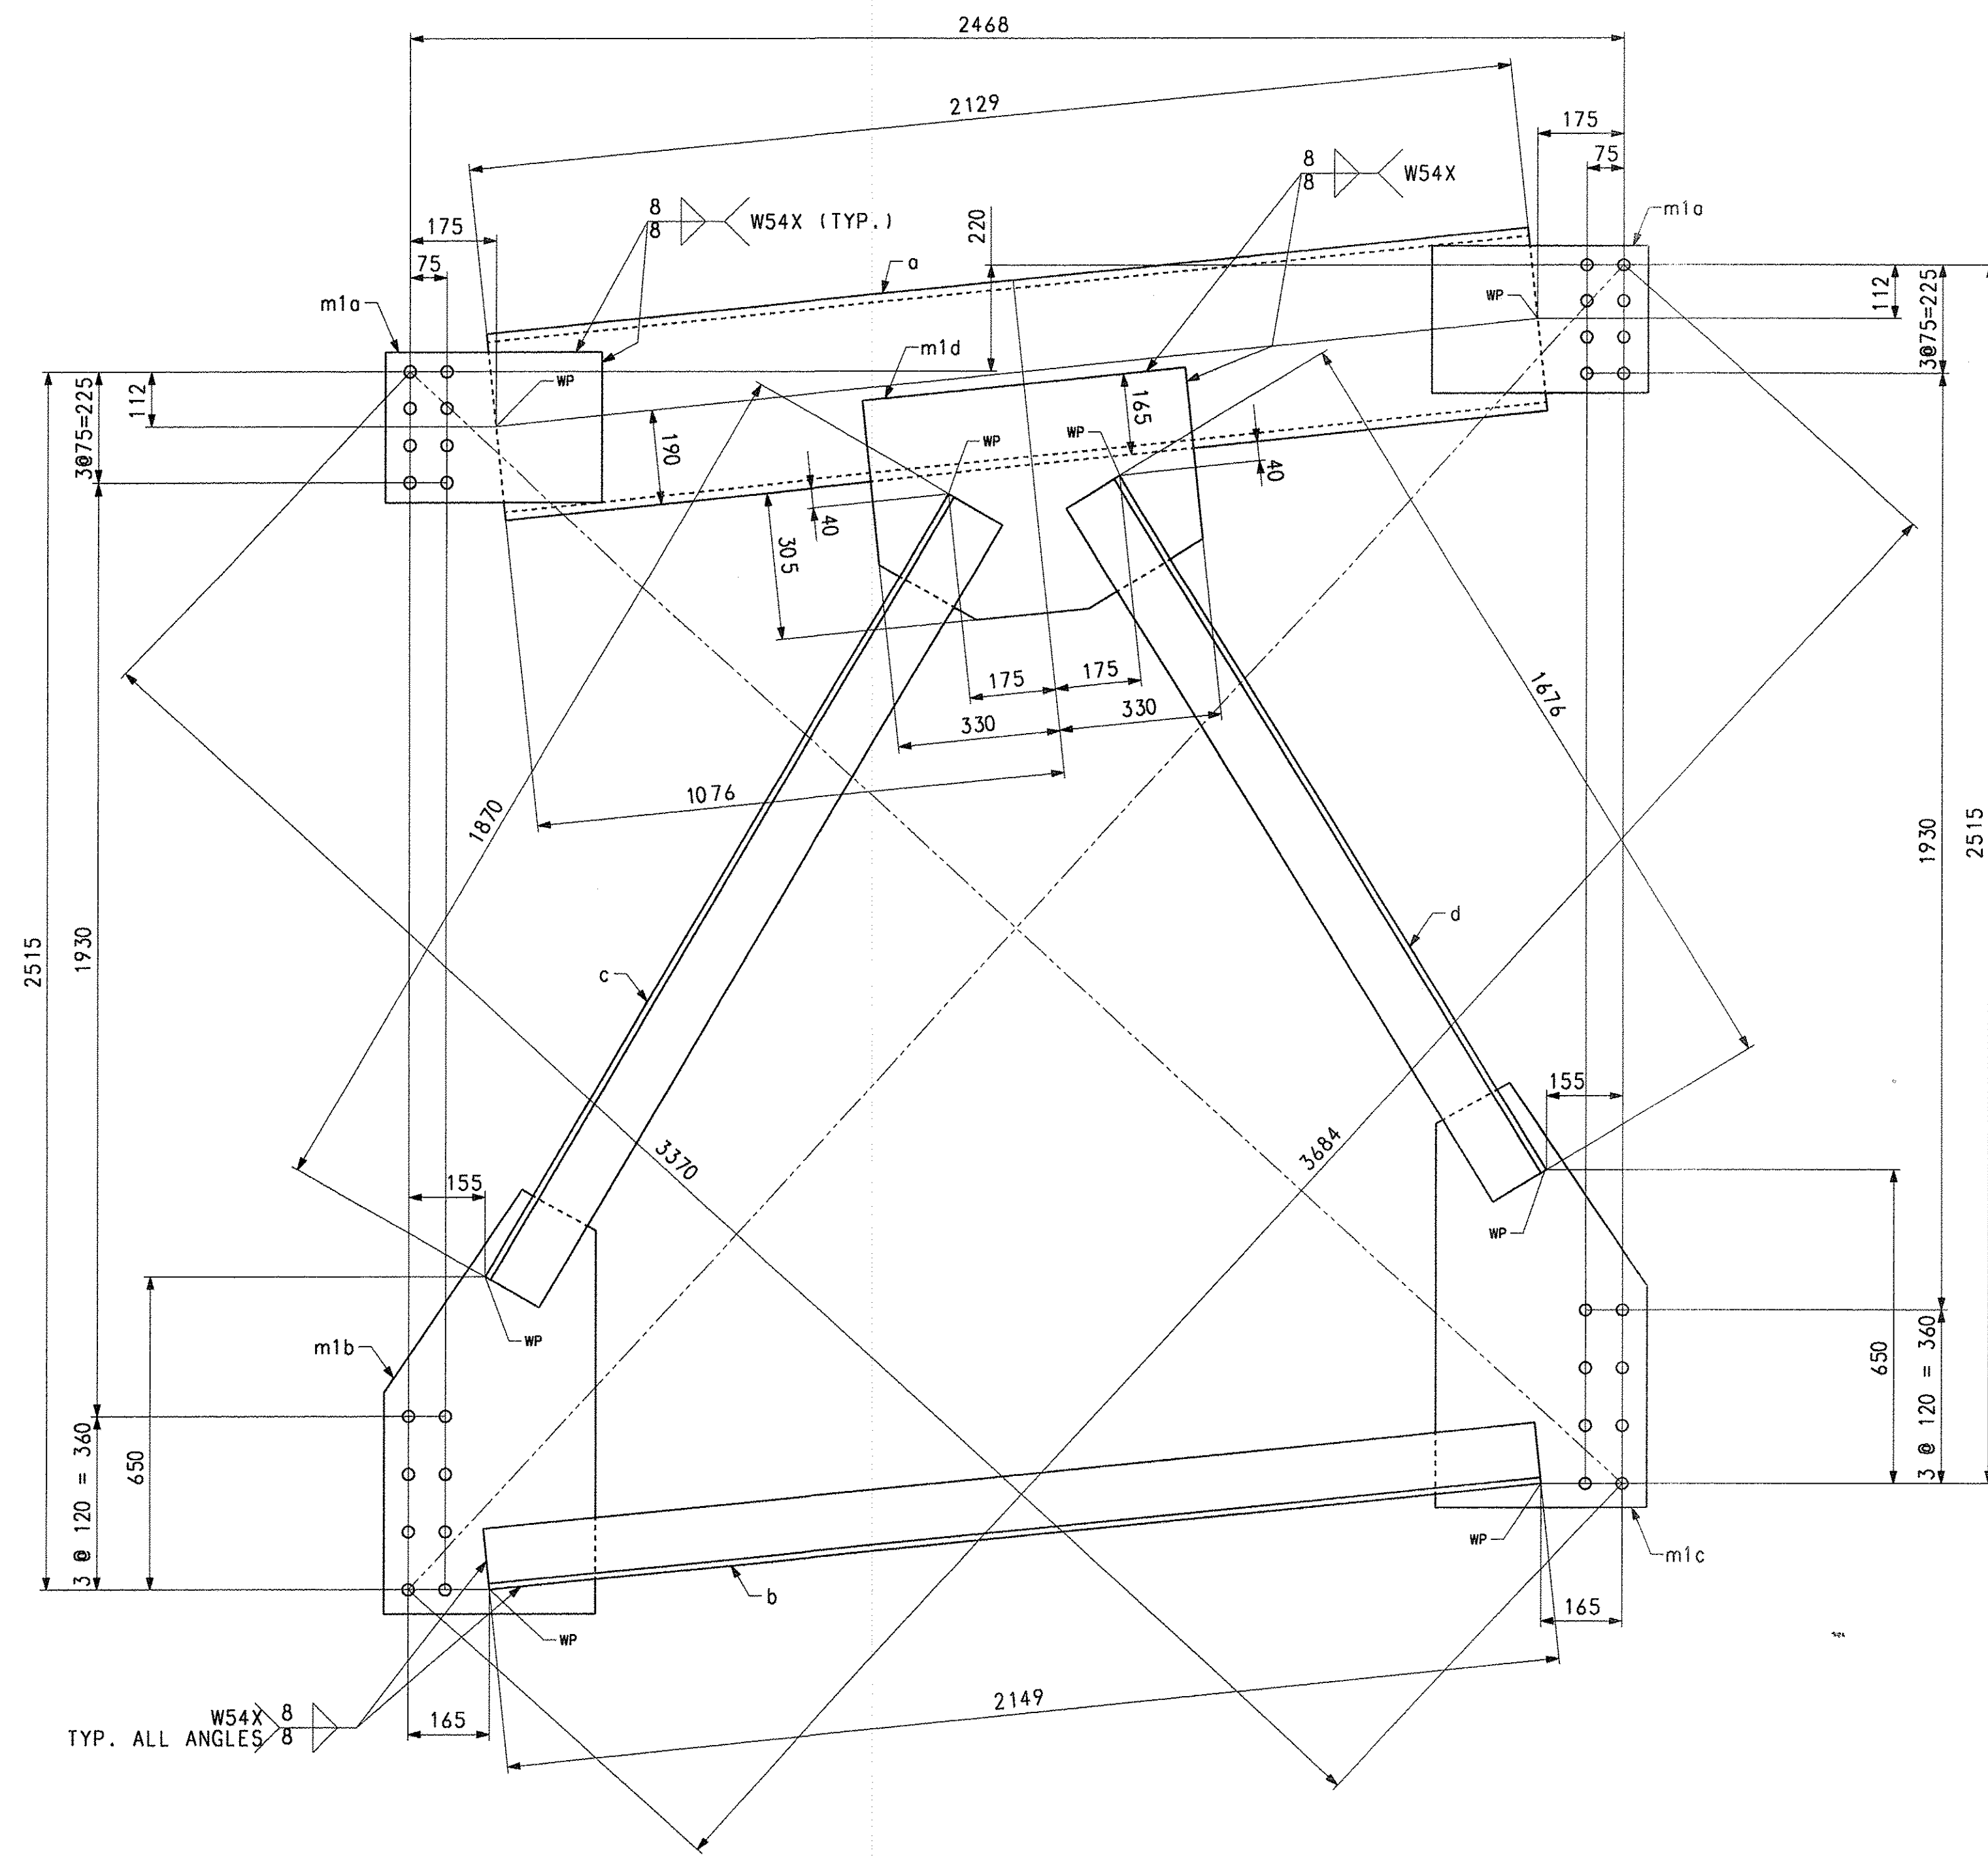

CROSSFRAME - MK. CF.1 (PAINT)

BILL OF MATERIAL

QTY	MARK	COMM.	DESCRIPTION	LENGTH	SPEC	GRADE	TEST	REMARKS	ITEM	GROSS WEIGHT EA.	DEDUCTED WEIGHT EA.	NET WEIGHT EA.
5	CF1		CROSSFRAME							380.29	0	380.29
1	o	C	380 x 50.4	2129	M270M	345W	T	(C15 x 33.9)	11001	107.30	0	107.30
1	b	L	127 x 127 x 12.7	2149	M270M	345W	T	(L5 x 5 x 1/2)	11002	52.13	0	52.13
1	c	L	127 x 127 x 12.7	1870	M270M	345W	T	(L5 x 5 x 1/2)	11002	45.37	0	45.37
1	d	L	127 x 127 x 12.7	1676	M270M	345W	T	(L5 x 5 x 1/2)	11002	40.86	0	40.86
2	m1a	PL	14.3 x 305	440	M270M	345W	T		11003	15.06	0	15.06
1	m1b	PL	14.3 x 430	880	M270M	345W	T		11003	42.47	0	42.47
1	m1c	PL	14.3 x 430	880	M270M	345W	T		11003	42.47	0	42.47
1	m1d	PL	14.3 x 470	660	M270M	345W	T		11003	34.82	0	34.82

TOTAL WEIGHT THIS SHEET: 1901.43 kgs

TVGA CONSULTANTS

NO EXCEPTIONS TAKEN REJECTED
 FURNISH AS CORRECTED
 REVISE AND RESUBMIT

ENGINEER has reviewed Shop Drawings and Samples and other data which Contractor is required to submit, only for performance with the information given in the Contract Documents and compliance with the design contract of the complete Project as a functioning whole as indicated in the Contract Documents. Such reviews do not extend to means, methods, techniques, sequences or procedures of construction or to safety precautions and programs incident thereto. Contractor is responsible for dimensions to be confirmed and controlled at the job site; for information that pertains solely to the fabrication processes or to techniques of construction; and for coordination of this work of all trades.

BY: *[Signature]*
 DATE: 1/18/08

NO.	REVISION	BY	CHK'D	DATE
HOLES: 15/16" Ø BOLTS: NONE COATING: SEE DWG. GN1 CODE(S): 63 SCALE: N.T.S. STATE CONT. OR REF. NO.: AC NH F019-1153 FED. AID PROJ. NO.: GENERAL CONTRACTOR: J. A. McDONALD, INC. HSSI PROJ. MGR: DEB KUPRES STATE: VT PROJECT NUMBER: S-1070147 HSSI PROJECT ID: A DRAWING NUMBER: 31 OF 34				
VT ROUTE 279 OVER FURNACE BROOK VT ROUTE 279 STA. 8+542.000 TO STA. 8+685.000 TOWN OF BENNINGTON VERMONT, BRIDGE B12 STATE OF VERMONT AGENCY OF TRANSPORTATION				
BRITIGAN (IH) MADE BY ERS CHECKED BY CS DATE 11-14-07				

NOTE:
 FOR GENERAL SHOP NOTES, SEE DRAWING GN1.