

METRIC

1

2


SHIPMENT 01

PMBENIG: 500281Z PRD: 5002818 SHIPAFRECT: 4 5002819

BY: MKredel

PLOTTER: 11/30/2007 12:31:20 PM

68

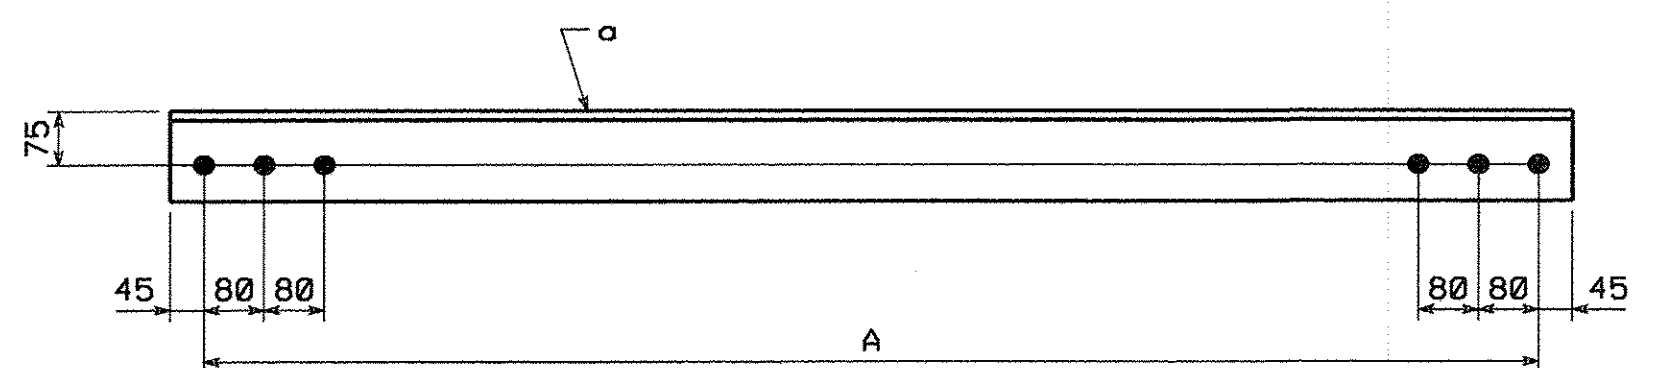

LATERAL BRACING

MARK	A	REMARKS
LB1	2573	NO PAINT
LB2	2573	PAINT
LB3	2565	NO PAINT
LB4	2565	PAINT
LB5	2558	NO PAINT
LB6	2558	PAINT
LB7	2550	NO PAINT
LB8	2550	PAINT
LB9	2543	NO PAINT
LB10	2543	PAINT
LB11	2535	NO PAINT
LB12	2535	PAINT
LB13	2450	NO PAINT
LB14	2443	NO PAINT
LB15	2437	NO PAINT
LB16	2430	NO PAINT
LB17	2423	NO PAINT
LB18	2416	NO PAINT
LB19	2414	PAINT
LB20	2406	PAINT
LB21	2400	PAINT
LB22	2393	PAINT
LB23	2388	PAINT
LB24	2381	PAINT
LB25	2306	PAINT
LB26	2298	PAINT
LB27	2290	PAINT
LB28	2287	PAINT
LB29	2280	PAINT

BILL OF MATERIAL												
QTY EA	MARK	COMM	DESCRIPTION	LENGTH	SPEC	GRADE	TEST	REMARKS	ITEM	GROSS WEIGHT EA	DEDUCTED WEIGHT EA	NET WEIGHT EA
1	LB15		LATERAL BRACING							61.31	0.00	61.31
1	a	L	127 x 127 x 12.7	2.527	M270M	345W	(L5x5x1/2)	12001				
1	LB16		LATERAL BRACING							61.14	0.00	61.14
1	a	L	127 x 127 x 12.7	2.520	M270M	345W	(L5x5x1/2)	12001				
1	LB17		LATERAL BRACING							60.97	0.00	60.97
1	a	L	127 x 127 x 12.7	2.513	M270M	345W	(L5x5x1/2)	12001				
1	LB18		LATERAL BRACING							60.80	0.00	60.80
1	a	L	127 x 127 x 12.7	2.506	M270M	345W	(L5x5x1/2)	12001				
1	LB19		LATERAL BRACING							60.75	0.00	60.75
1	a	L	127 x 127 x 12.7	2.504	M270M	345W	(L5x5x1/2)	12001				
1	LB20		LATERAL BRACING							60.55	0.00	60.55
1	a	L	127 x 127 x 12.7	2.496	M270M	345W	(L5x5x1/2)	12001				
1	LB21		LATERAL BRACING							60.41	0.00	60.41
1	a	L	127 x 127 x 12.7	2.490	M270M	345W	(L5x5x1/2)	12001				
1	LB22		LATERAL BRACING							60.24	0.00	60.24
1	a	L	127 x 127 x 12.7	2.483	M270M	345W	(L5x5x1/2)	12001				
1	LB23		LATERAL BRACING							60.12	0.00	60.12
1	a	L	127 x 127 x 12.7	2.478	M270M	345W	(L5x5x1/2)	12001				
1	LB24		LATERAL BRACING							59.95	0.00	59.95
1	a	L	127 x 127 x 12.7	2.471	M270M	345W	(L5x5x1/2)	12001				
1	LB25		LATERAL BRACING							58.13	0.00	58.13
1	a	L	127 x 127 x 12.7	2.396	M270M	345W	(L5x5x1/2)	12001				
2	LB26		LATERAL BRACING							57.93	0.00	57.93
1	a	L	127 x 127 x 12.7	2.388	M270M	345W	(L5x5x1/2)	12001				
1	LB27		LATERAL BRACING							57.74	0.00	57.74
1	a	L	127 x 127 x 12.7	2.380	M270M	345W	(L5x5x1/2)	12001				
1	LB28		LATERAL BRACING							57.67	0.00	57.67
1	a	L	127 x 127 x 12.7	2.377	M270M	345W	(L5x5x1/2)	12001				
1	LB29		LATERAL BRACING							57.50	0.00	57.50
1	a	L	127 x 127 x 12.7	2.370	M270M	345W	(L5x5x1/2)	12001				
TOTAL WEIGHT THIS SHEET:										11 467.41 kgs		
TOTAL WEIGHT FOR BID ITEM NO. 0160 506.56:										662 078.97 kgs		
TOTAL WEIGHT FOR BID ITEM NO. 0990 900.635:										266 371.08 kgs		


BILL OF MATERIAL												
QTY EA	MARK	COMM	DESCRIPTION	LENGTH	SPEC	GRADE	TEST	REMARKS	ITEM	GROSS WEIGHT EA	DEDUCTED WEIGHT EA	NET WEIGHT EA
26	LB1		LATERAL BRACING							64.60	0.00	64.60
1	a	L	127 x 127 x 12.7	2.663	M270M	345W	(L5x5x1/2)	12001				
1	LB2		LATERAL BRACING							64.60	0.00	64.60
1	a	L	127 x 127 x 12.7	2.663	M270M	345W	(L5x5x1/2)	12001				
26	LB3		LATERAL BRACING							64.41	0.00	64.41
1	a	L	127 x 127 x 12.7	2.655	M270M	345W	(L5x5x1/2)	12001				
1	LB4		LATERAL BRACING							64.41	0.00	64.41
1	a	L	127 x 127 x 12.7	2.655	M270M	345W	(L5x5x1/2)	12001				
26	LB5		LATERAL BRACING							64.24	0.00	64.24
1	a	L	127 x 127 x 12.7	2.648	M270M	345W	(L5x5x1/2)	12001				
1	LB6		LATERAL BRACING							64.24	0.00	64.24
1	a	L	127 x 127 x 12.7	2.648	M270M	345W	(L5x5x1/2)	12001				
26	LB7		LATERAL BRACING							64.05	0.00	64.05
1	a	L	127 x 127 x 12.7	2.640	M270M	345W	(L5x5x1/2)	12001				
1	LB8		LATERAL BRACING							64.05	0.00	64.05
1	a	L	127 x 127 x 12.7	2.640	M270M	345W	(L5x5x1/2)	12001				
26	LB9		LATERAL BRACING							63.88	0.00	63.88
1	a	L	127 x 127 x 12.7	2.633	M270M	345W	(L5x5x1/2)	12001				
1	LB10		LATERAL BRACING							63.88	0.00	63.88
1	a	L	127 x 127 x 12.7	2.633	M270M	345W	(L5x5x1/2)	12001				
26	LB11		LATERAL BRACING							63.68	0.00	63.68
1	a	L	127 x 127 x 12.7	2.625	M270M	345W	(L5x5x1/2)	12001				
1	LB12		LATERAL BRACING							63.68	0.00	63.68
1	a	L	127 x 127 x 12.7	2.625	M270M	345W	(L5x5x1/2)	12001				
1	LB13		LATERAL BRACING							61.62	0.00	61.62
1	a	L	127 x 127 x 12.7	2.540	M270M	345W	(L5x5x1/2)	12001				
1	LB14		LATERAL BRACING							61.45	0.00	61.45
1	a	L	127 x 127 x 12.7	2.533	M270M	345W	(L5x5x1/2)	12001				

TVGA CONSULTANTS

NO EXCEPTIONS TAKEN REJECTED
 FURNISH AS CORRECTED
 REVISE AND RESUBMIT

ENGINEER has reviewed Shop Drawings and Samples and other data which Contractor is required to submit, only for conformance with the information given in the Contract Documents and compatibility with the design concept of the completed Project as a functioning whole as indicated in the Contract Documents. Such reviews do not extend to means, methods, technique, sequences or procedures of construction or to safety precautions and programs incident thereto. Contractor is responsible for dimensions to be confirmed and coordinated at the job site for information that pertains solely to the fabrication processes or to techniques of construction, and for coordination of the work of all trades.

BY: *[Signature]*
DATE: 1/11/08

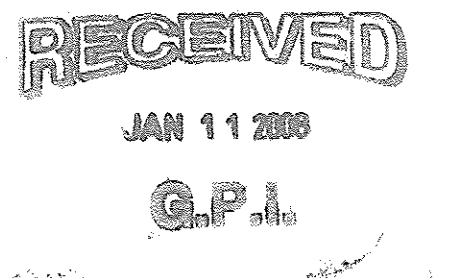

FOR GENERAL SHOP NOTES, SEE DRAWING GNI.

NO.	REVISION	BY	CHK'D	DATE
HOLES	1/16" #			
BOLTS	NONE			
COATING	SEE DWG. GNI (U.N.)			
CODE(S)	64			
SCALE	N.T.S.			
GENERAL CONTRACTOR	J.A. McDONALD, INC.	FED. AID PROJ. NO.		
DRAWING MANAGER	BRITIGAN (IH)	MADE BY	CHK'D BY	DATE
STATE	VT	WBW	C5	11-26-07
HSSI PROJECT NUMBER	S-1070147	HSSI STRUCT. ID	A	DRAWING NUMBER
				34 OF 34

