


METRIC

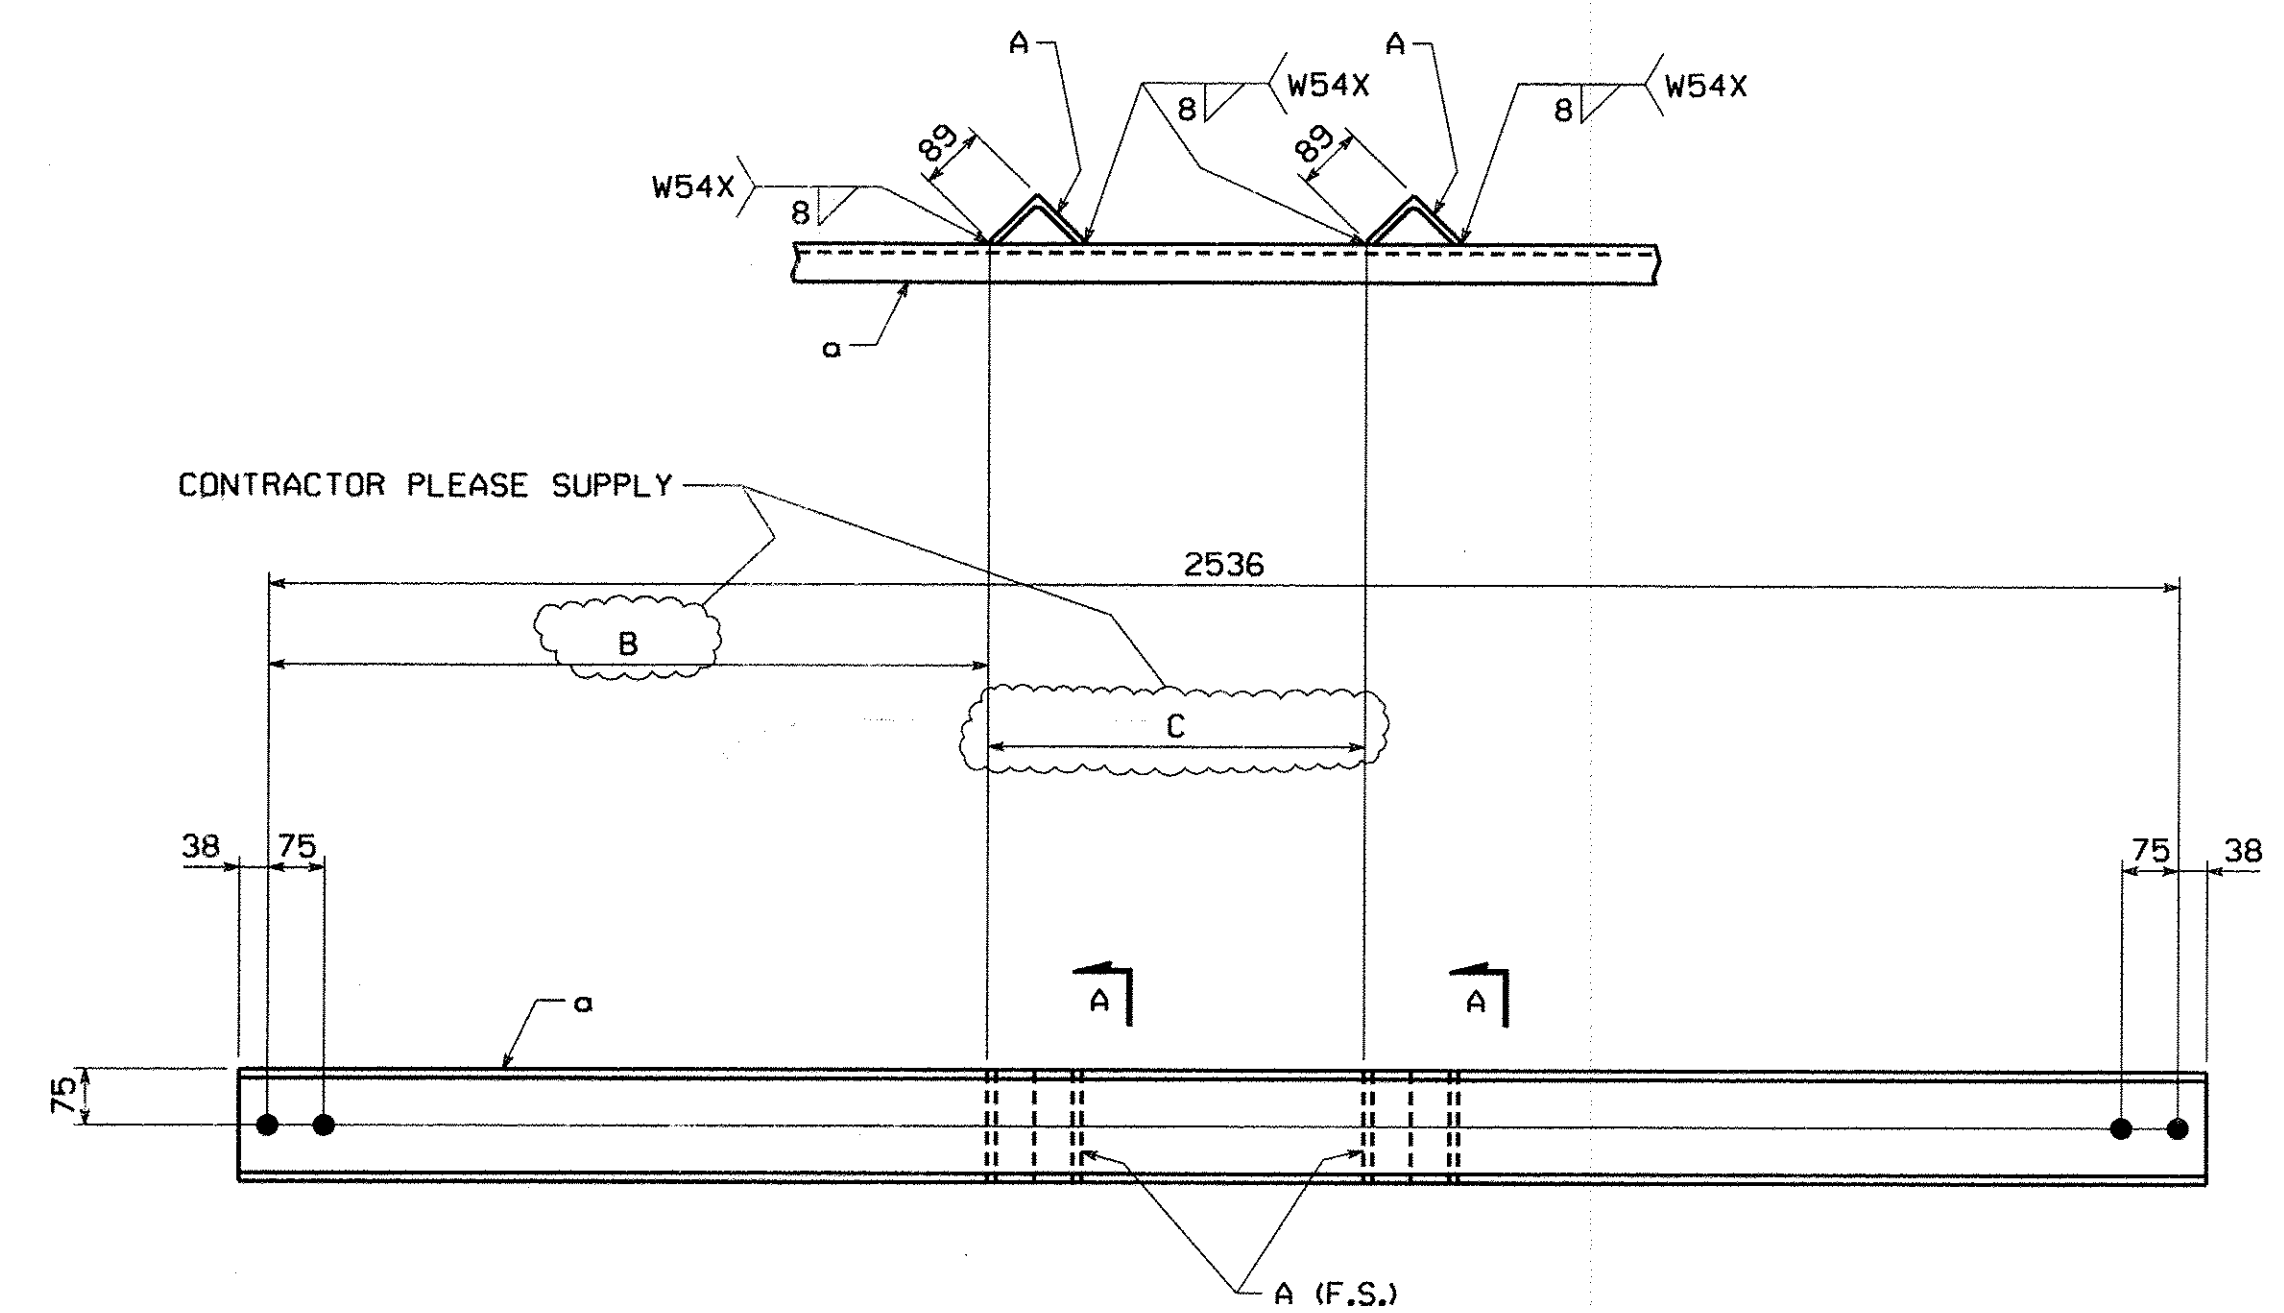

MARK	A	B	C	REMARKS
D1	m100	XXXX	XXXX	NO PAINT
D2	m108	XXXX	XXXX	PAINT
D3	m100	XXXX	XXXX	NO PAINT
D4	m108	XXXX	XXXX	PAINT

SECTION A

BILL OF MATERIAL												
QTY EA	MARK	COMM	DESCRIPTION	LENGTH	SPEC	GRADE	TEST	REMARKS	ITEM	GROS WEIGHT EA	DEDUCTED WEIGHT	NET WEIGHT EA
21	D1		DIAPHRAGM							44.55	0.00	44.55
1	a	C	150 x 15.6	2612	M270M	345W			10001	40.75	0.00	40.75
2	m100	L	89 x 89 x 9.5	150	M270M	345W			11004	1.90	0.00	1.90
1	D2		DIAPHRAGM							44.55	0.00	44.55
1	a	C	150 x 15.6	2612	M270M	345W			10001	40.75	0.00	40.75
2	m108	L	89 x 89 x 9.5	150	M270M	345W			11004	1.90	0.00	1.90
23	D3		DIAPHRAGM							44.55	0.00	44.55
1	a	C	150 x 15.6	2612	M270M	345W			10001	40.75	0.00	40.75
2	m100	L	89 x 89 x 9.5	150	M270M	345W			11004	1.90	0.00	1.90
1	D4		DIAPHRAGM							44.55	0.00	44.55
1	a	C	150 x 15.6	2612	M270M	345W			10001	40.75	0.00	40.75
2	m108	L	89 x 89 x 9.5	150	M270M	345W			11004	1.90	0.00	1.90
<b>TOTAL WEIGHT THIS SHEET:</b>										<b>2049.08 kgs</b>		
<b>TOTAL WEIGHT FOR BID ITEM NO. 0155 506.56:</b>										<b>120,388.59 kgs</b>		

NOTES:  
FOR GENERAL SHOP NOTES, SEE DRAWING GNI.

△						
△						
△						
NO.	REVISION			BY	CHK'D	DATE
HOLES	15/16" ø					
BOLTS	NONE	DIAPHRAGMS D1 THRU D4				
COATING	EAST ROAD OVER VT ROUTE 279					
SEE DWG.	EAST ROAD STA. 1+148.400 TO STA. 1+220.200					
CODE(S)	TOWN OF BENNINGTON VERMONT, BRIDGE B11					
56	STATE OF VERMONT					
N.T.S.	AGENCY OF TRANSPORTATION					
SCALE	AC NH 019-1053	FED. AID PROJ. NO.				
N.T.S.	GENERAL CONTRACTOR J.A. McDONALD, INC.		HSSI PROJ. MGR	DEB KUPRES		
SHPMT	DRAWING MANAGER BRITIGAN (JH)	MADE BY WBW	CHK'D BY CS	DATE	9-19-07	
STATE VT	HSSI PROJECT NUMBER S-1070147	HSSI STRUCT. ID B	DRAWING NUMBER	12 OF 12		

BY: Mkr...  
 PLOTTED: 10/1/2007 9:23:02 AM  
 SHIPMENT 01  
 PAKENGS: 5082811 PRO: 5082812 SHIPPERCT: 5082813