


CROSSFRAME - MK, CF3

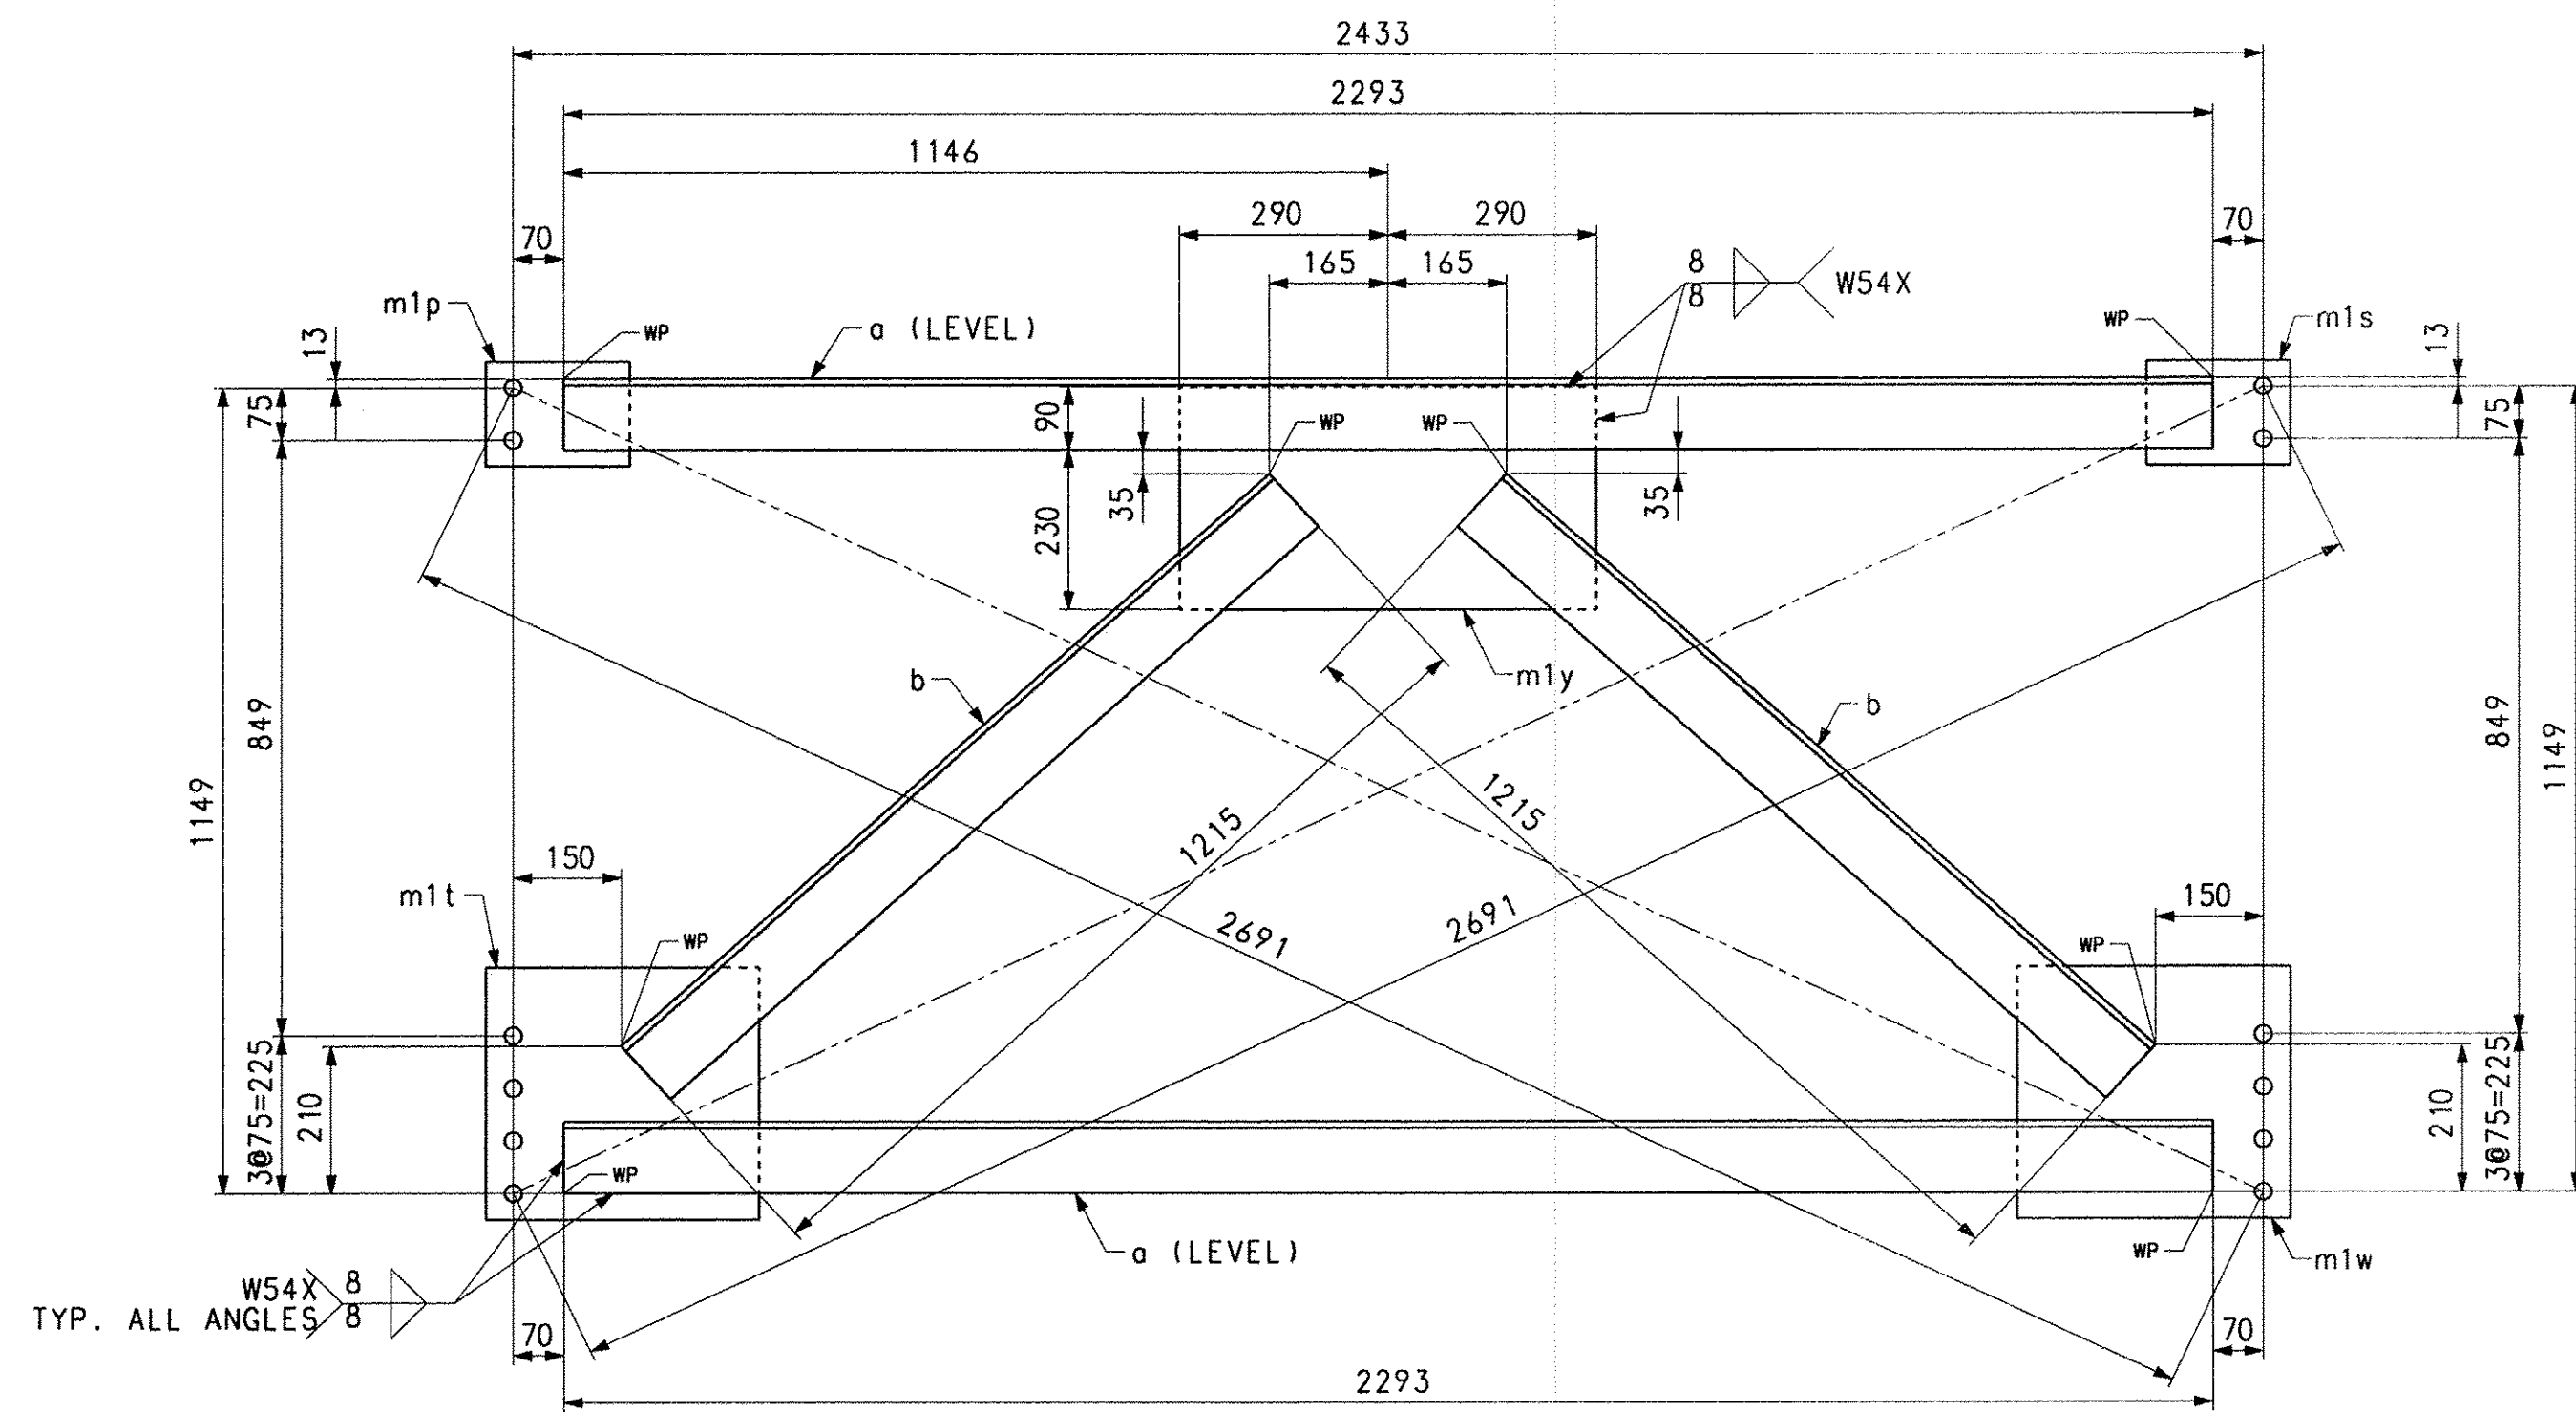

CROSSFRAME - MK, CF4

NOTES:
FOR GENERAL SHOP NOTES, SEE DRAWING GN1.

BILL OF MATERIAL

QTY	MARK	COMMODITY	DESCRIPTION	LENGTH	SPEC	GRADE	TEST	REMARKS	ITEM	GROSS WEIGHT EA.	DEDUCTED WEIGHT EA.	NET WEIGHT EA.
1	CF3		CROSSFRAME							157.81		157.81
2	o	L	102 x 102 x 9.5	2263	M270M	345W		(L4x4x3/8)	11002	32.72		32.72
2	b	L	102 x 102 x 9.5	1179	M270M	345W		(L4x4x3/8)	11002	17.05		17.05
1	mlp	PL	14.3 x 151	200	M270M	345W			11003	3.39		3.39
1	mls	PL	14.3 x 151	200	M270M	345W			11003	3.39		3.39
1	mlt	PL	14.3 x 360	380	M270M	345W			11003	15.34		15.34
1	mlw	PL	14.3 x 360	380	M270M	345W			11003	15.34		15.34
1	mly	PL	14.3 x 320	580	M270M	345W			11003	20.81		20.81
4	CF4		CROSSFRAME							159.72		159.72
2	o	L	102 x 102 x 9.5	2293	M270M	345W		(L4x4x3/8)	11002	33.16		33.16
2	b	L	102 x 102 x 9.5	1215	M270M	345W		(L4x4x3/8)	11002	17.57		17.57
1	mlp	PL	14.3 x 151	200	M270M	345W			11003	3.39		3.39
1	mls	PL	14.3 x 151	200	M270M	345W			11003	3.39		3.39
1	mlt	PL	14.3 x 360	380	M270M	345W			11003	15.34		15.34
1	mlw	PL	14.3 x 360	380	M270M	345W			11003	15.34		15.34
1	mly	PL	14.3 x 320	580	M270M	345W			11003	20.81		20.81
TOTAL WEIGHT THIS SHEET:										796.70	kgs	

NO.	REVISION	BY	CHK'D	DATE
HOLES: 15/16" Ø BOLTS: NONE COATING: NONE CODE(S): 63 SCALE: N.T.S. SHPMT: 2 STATE: VT				
CROSSFRAMES CF3 & CF4 SHARED USE PATH OVER VT ROUTE 279 SHARED USE PATH STA. 1+148.400 TO STA. 1+220.200 TOWN OF BENNINGTON VERMONT, BRIDGE B11 STATE OF VERMONT AGENCY OF TRANSPORTATION STATE CONT. OR REF. NO.: AC NH 019-11531 GENERAL CONTRACTOR: J. A. McDONALD, INC. FEDERAL AID PROJ. NO.: HSSI PROJ. NO.: HSSI STRUCT. ID: S-1070147				
MADE BY: WBW CHECKED BY: CS DATE: 9-25-07 DRAWING NUMBER: 6 OF 7				