


BILL OF MATERIAL (SOUTH RAIL)					
Mark #	Qty.	Description	Size/Shape	Length/Qty per unit	Material
3P	38	W150x37 POST W/BASEPLATE 1110 OAL			
	38	POST UPRIGHT	W150 x 37	1085	A709M Gr. 345
	38	POST BASE PLATE	254 x 25	356	A709M Gr. 345
	38	BEARING PAD	254 x 3	356	NEOPRENE
P1	2	TS 102 x 102 x 6 TOP & BOTTOM RAILS		4.708m	A500 Gr. B
	1	TS 152 x 102 x 8 MIDDLE RAIL		4.708m	A500 Gr. B
P2	16	TS 102 x 102 x 6 TOP & BOTTOM RAILS		7.182m	A500 Gr. B
	8	TS 152 x 102 x 8 MIDDLE RAIL		7.182m	A500 Gr. B
P3	4	TS 102 x 102 x 6 TOP & BOTTOM RAILS		7.160m	A500 Gr. B
	2	TS 152 x 102 x 8 MIDDLE RAIL		7.160m	A500 Gr. B
P4	2	TS 102 x 102 x 6 TOP & BOTTOM RAILS		4.835m	A500 Gr. B
	1	TS 152 x 102 x 8 MIDDLE RAIL		4.835m	A500 Gr. B
P5	2	TS 102 x 102 x 6 TOP & BOTTOM RAILS		7.690m	A500 Gr. B
	1	TS 152 x 102 x 8 MIDDLE RAIL		7.690m	A500 Gr. B
	24	TS 76 x 76 x 8 SPLICE TUBE W/ WELDED NUTS		510	A500 Gr. B
	12	TS 127 x 76 x 8 SPLICE TUBE W/ WELDED NUTS		510	A500 Gr. B
	84	DN 20 SCH. 40 PIPE SPACER		13	A53 Gr. B
	144	M16 SPLICE HEX BOLT W/ HARDENED WASHER		44	A325M
	228	M20 ROUND HEAD BOLT		152	M164M
	228	M20 HEX NUT			A563 DH
	228	M20 WASHER			F436M

SPLICES SAME TO SH. 8 TYP.



RECEIVED
JUN 27 2008
G.P.I.

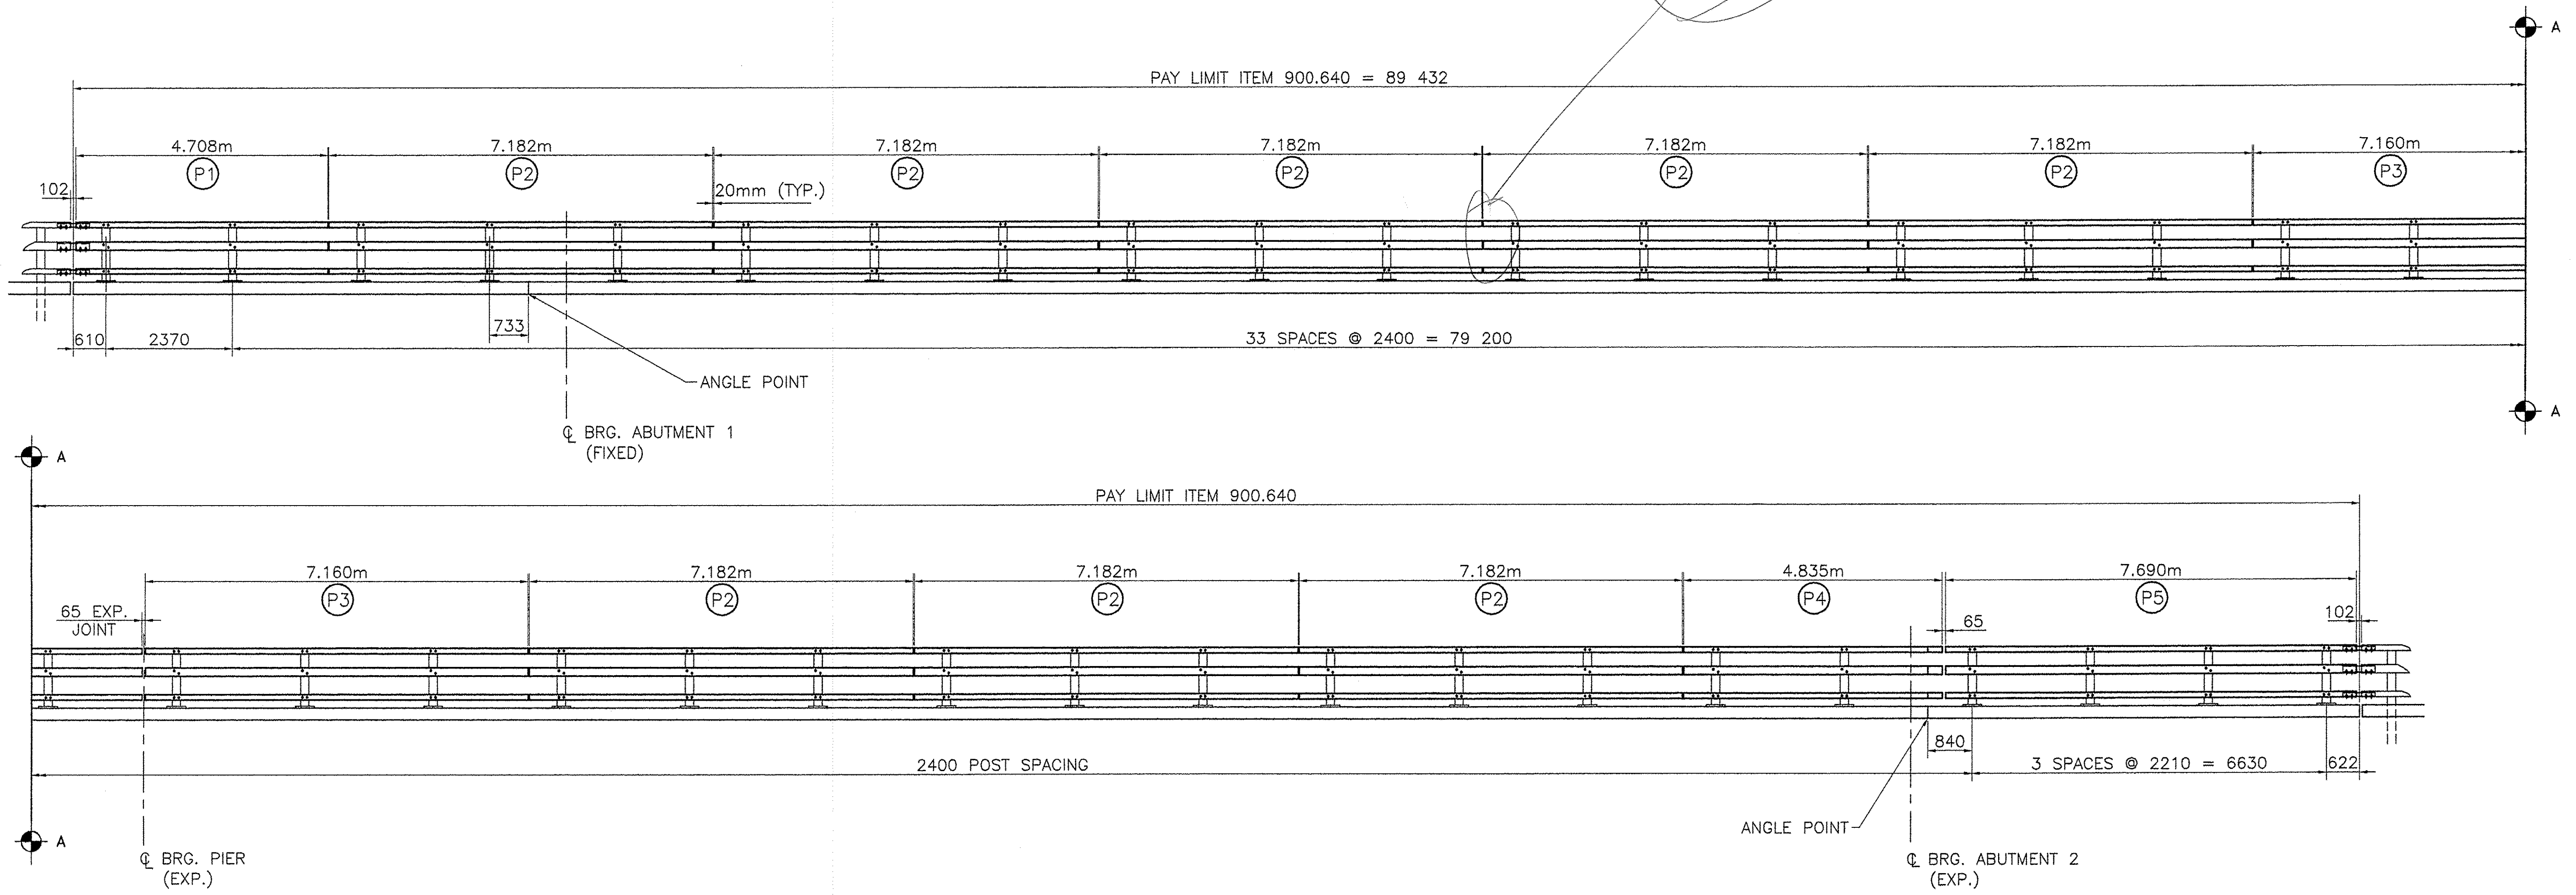

WEST RAIL ELEVATION
LOOKING WEST FROM CL OF ROAD
(SHARED USE PATH)

REVISIONS		
No.	Remarks	Date
0	Initial submittal	2/15/08
1	Added tube splices	6/5/08

DATE: 6/27/08
SIGNATURE: ZLK
REVISION: 1
REVISION: 2

HIGHWAY SAFETY CORP.
GLASTONBURY, CT

ITEM 900.640 BRIDGE RAILING - 3 RAIL
TOWN OF BENNINGTON
COUNTY OF BENNINGTON
PROJECT AC NH 019-1(53) BRIDGE B11
EAST ROAD OVER VT ROUTE 279

DRAWN: MHM
CHECKED: P Radice
DATE: 12/30/07
SCALE: N.T.S.
HSO REFERENCE NO.: 1615

GENERAL CONTRACTOR: F.R. LAFAYETTE, INC.
SUB CONTRACTOR: F.R. LAFAYETTE, INC.

SIZE: D REVISION: A
SHEET NO.: 5 of 11