


BILL OF MATERIAL (SOUTH RAIL)					
Mark #	Qty.	Description	Size/Shape	Length/Qty per unit	Material
3P	31	W150x37 POST W/BASEPLATE 1110 OAL			
		POST UPRIGHT	W150 x 37	592	A709M Gr. 345
		POST BASE PLATE	254 x 25	356	A709M Gr. 345
	31	BEARING PAD	254 x 3	356	NEOPRENE
P2	14	TS 102 x 102 x 6 TOP & BOTTOM RAILS		7.182m	A500 Gr. B
	7	TS 152 x 102 x 8 MIDDLE RAIL		7.182m	A500 Gr. B
P3	2	TS 102 x 102 x 6 TOP & BOTTOM RAILS		7.160m	A500 Gr. B
	1	TS 152 x 102 x 8 MIDDLE RAIL		7.160m	A500 Gr. B
P6	2	TS 102 x 102 x 6 TOP & BOTTOM RAILS		4.740m	A500 Gr. B
	1	TS 152 x 102 x 8 MIDDLE RAIL		4.740m	A500 Gr. B
P7	2	TS 102 x 102 x 6 TOP & BOTTOM RAILS		7.104m	A500 Gr. B
	1	TS 152 x 102 x 8 MIDDLE RAIL		7.104m	A500 Gr. B
P8	2	TS 102 x 102 x 6 TOP & BOTTOM RAILS		3.153m	A500 Gr. B
	1	TS 152 x 102 x 8 MIDDLE RAIL		3.153m	A500 Gr. B
	20	TS 76 x 76 x 8 SPLICE TUBE W/ WELDED NUTS		510	A500 Gr. B
	10	TS 127 x 76 x 8 SPLICE TUBE W/ WELDED NUTS		510	A500 Gr. B
	120	M16 SPLICE HEX BOLT W/ HARDENED WASHER		44	A325M
	66	DN 20 SCH. 40 PIPE SPACER		13	A53 Gr. B
	186	M20 ROUND HEAD BOLT		152	M164M
	186	M20 HEX NUT			A563 DH
	186	M20 WASHER			F436M

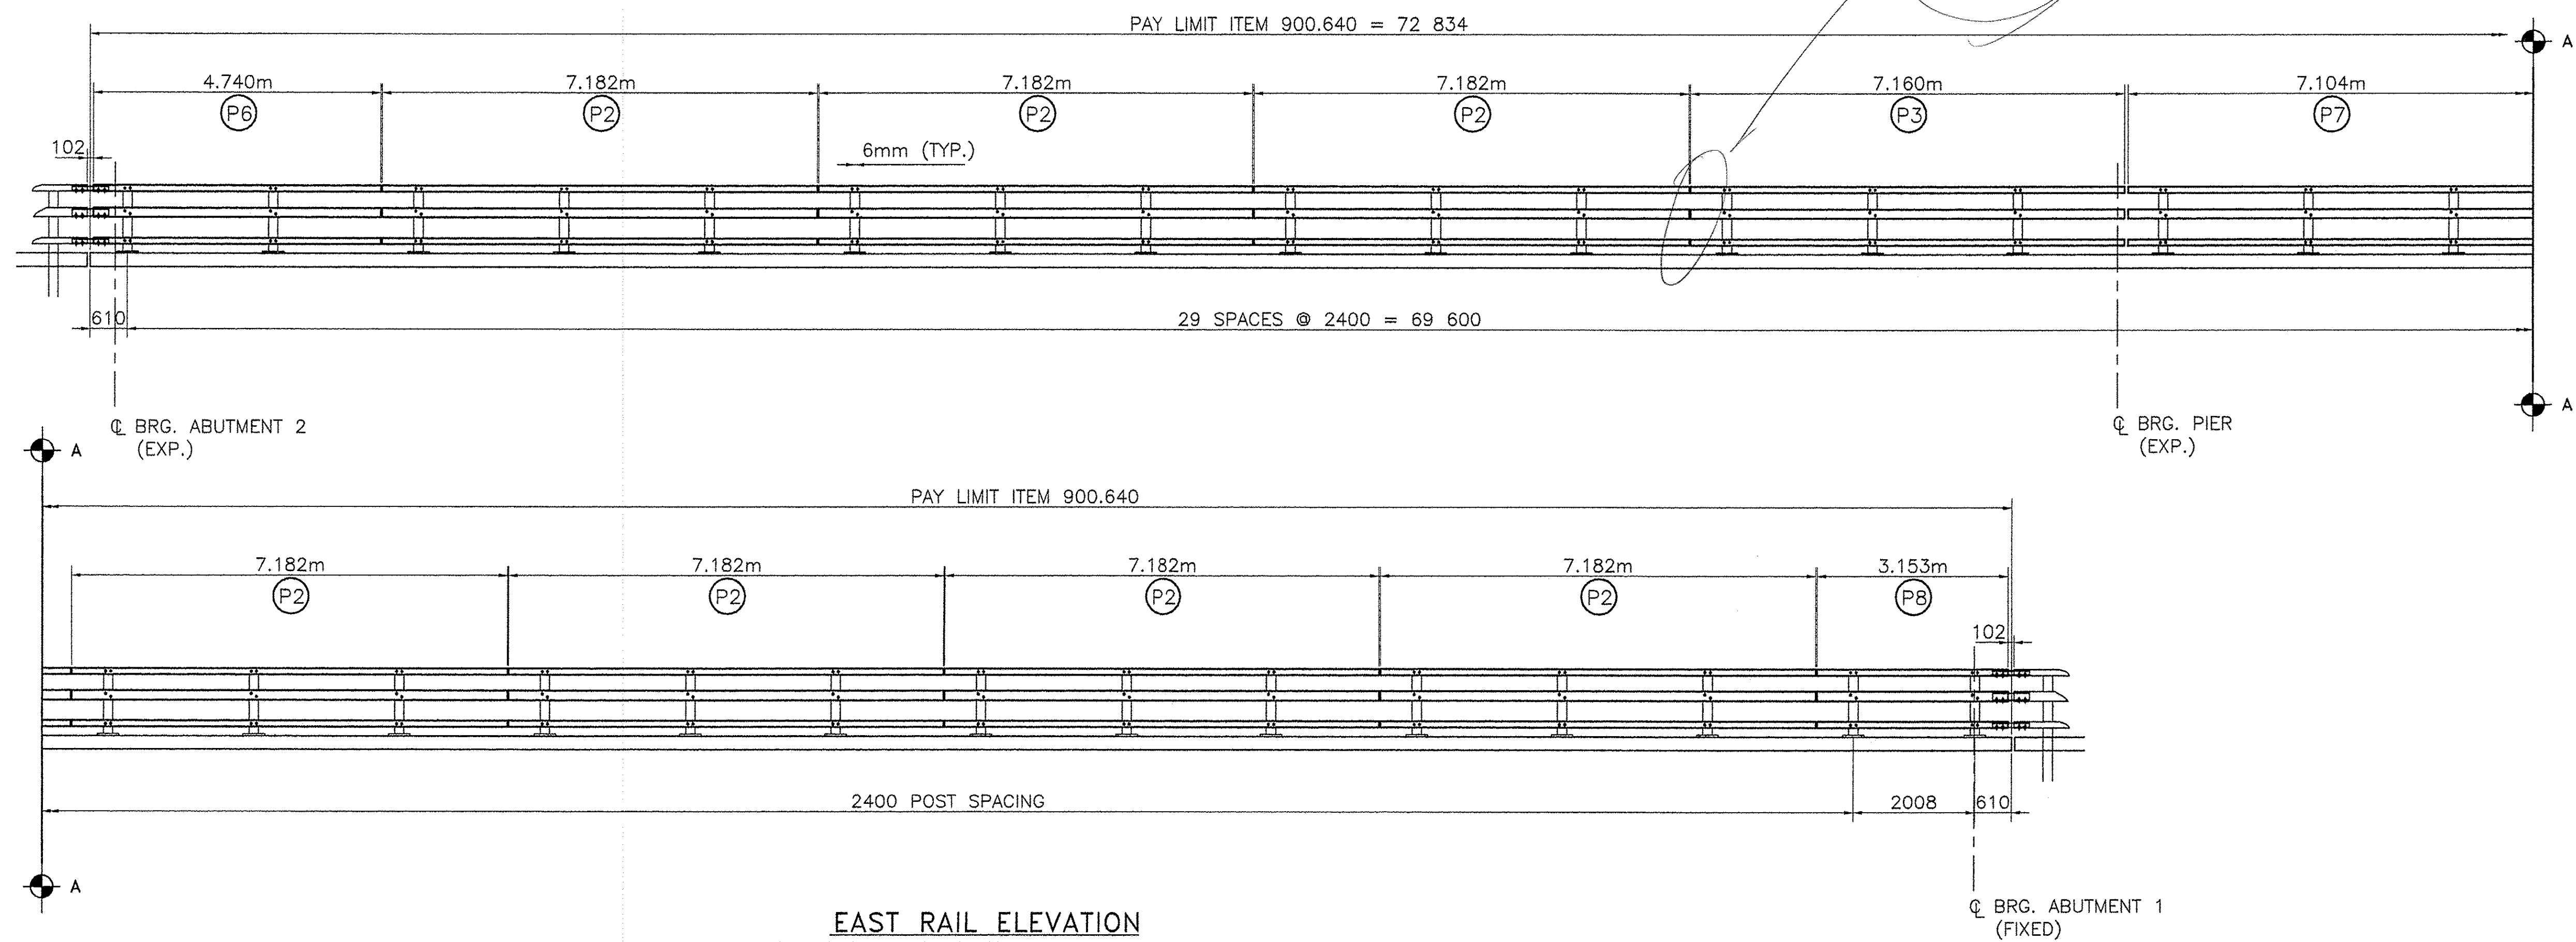

EAST RAIL ELEVATION  
LOOKING EAST FROM Q OF ROAD  
(SHARED USE PATH)

RECEIVED  
JUN 27 2008  
G.P.I.



REVISIONS		
No.	Remarks	Date
0	Initial submittal	2/15/08
1	Added tube splices	6/5/08

6/24/08  
ZK

DATE: 6/24/08  
SIGNATURE: ZK

REVIEW BY: [ ]  
DESIGN: [ ]  
CHECKED: [ ]  
DATE: [ ]

**HIGHWAY SAFETY CORP.**  
GLASTONBURY, CT

ITEM 900.640 BRIDGE RAILING - 3 RAIL  
TOWN OF BENNINGTON  
COUNTY OF BENNINGTON  
PROJECT AC NH 019-1(53) BRIDGE B11  
EAST ROAD OVER VT ROUTE 279

DRAWN: MHM  
CHECKED: P Radice  
DATE: 12/30/07  
SCALE: N.T.S.  
HSC REFERENCE NO.: 1615

GENERAL CONTRACTOR: [ ]  
SUB CONTRACTOR: F.R. LAFAYETTE, INC.

SHEET NO.: 6 of 11