

STATE OF VERMONT
 AGENCY OF TRANSPORTATION





PROPOSED IMPROVEMENT
 TOWNS OF WOODFORD - SEARSBURG
 COUNTY OF BENNINGTON

VERMONT ROUTE 9

BEGINNING AT M.M. 8.686 IN THE TOWN OF WOODFORD AND EXTENDING EASTERLY 4.430 MILES TO M.M. 3.541 IN THE TOWN OF SEARSBURG.

LENGTH OF PROJECT = 4,430 MILES
 LENGTH OF ROADWAY = 4,430 MILES

WORK TO BE PERFORMED UNDER THIS PROJECT INCLUDES PAVING AT AN EXISTING PULL OFF, COLD PLANING, RESURFACING OF THE EXISTING HIGHWAY WITH A LEVELING COURSE, WEARING COURSE, NEW PAVEMENT MARKINGS, SIGNS AND INCIDENTAL ITEMS AS SHOWN IN THE PROJECT QUANTITIES.

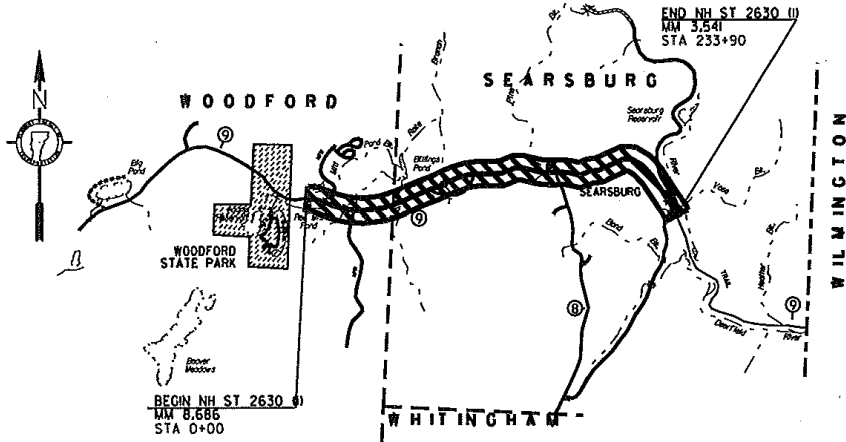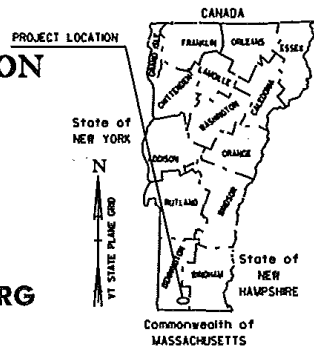

RECORD PLANS

CONTRACTOR: KUBRICKY CONSTRUCTION CORP. - GLENS FALLS, NY

RESIDENT ENGINEER: JUDY GILMORE

CONSTRUCTION BEGAN: JULY 27, 2009

CONSTRUCTION COMPLETE: NOVEMBER 19, 2009

RECORD PLANS BY: JUDY GILMORE & AMOS KEMPTON

I HEREBY CERTIFY THAT ALL THE CONSTRUCTION REQUIRED BY THIS SET OF DRAWINGS HAS BEEN ACCOMPLISHED AS INDICATED HEREIN.

BY Judy Gilmore RESIDENT ENGINEER

DATE 24 Aug 2011

NOTE: Any further information concerning final quantities, amounts or other details relative to this project may be found at Central Files in the electronic archives.

THESE PLANS ARE SUBJECT TO SUCH ENGINEERING CHANGES AS MAY BE REQUIRED BY THE FEDERAL HIGHWAY ADMINISTRATION OR THE DIRECTOR OF PROGRAM DEVELOPMENT. CONSTRUCTION IS TO BE CARRIED ON IN ACCORDANCE WITH THESE PLANS AND THE STANDARD SPECIFICATIONS FOR CONSTRUCTION DATED 2006, AS APPROVED BY THE FEDERAL HIGHWAY ADMINISTRATION ON JANUARY 15, 2006 FOR USE ON THIS PROJECT, INCLUDING ALL SUBSEQUENT REVISIONS AND SUCH REVISED SPECIFICATIONS AND SPECIAL PROVISIONS AS ARE INCORPORATED IN THESE PLANS.

DIRECTOR OF PROGRAM DEVELOPMENT

APPROVED _____ DATE _____

PROJECT MANAGER: TED DOMEY

PROJECT WOODFORD - SEARSBURG
 NH ST 2630 (I)

SHEET 1a OF 24 SHEETS