

COLD PLANE SECTION


WOODFORD
 MM 8.686 TO MM 9.575, (FULL WIDTH)
 SEARSBURG
 MM 0.00 TO MM 3.541, (FULL WIDTH)

PROJECT PAVING LIMITS

TOWN	BEGIN STATION	END STATION	LANE TYP	PAVED WIDTH	NOTES
WOODFORD	8.686	9.575	12'	40'	COLD PLANE 2", LEVEL WITH 1/2" TYPE IVS AND PAVE WITH 1-1/2" TYPE IVS
SEARSBURG	0.000	1.09	12'	34'	COLD PLANE 2", LEVEL WITH 1/2" TYPE IVS AND PAVE WITH 1-1/2" TYPE IVS
	1.09	1.50	12'	30'	COLD PLANE 2", LEVEL WITH 1/2" TYPE IVS AND PAVE WITH 1-1/2" TYPE IVS
	1.50	1.57	12'	32'	COLD PLANE 2", LEVEL WITH 1/2" TYPE IVS AND PAVE WITH 1-1/2" TYPE IVS
	1.57	2.49	12'	38'	COLD PLANE 2", LEVEL WITH 1/2" TYPE IVS AND PAVE WITH 1-1/2" TYPE IVS
	2.49	2.55	12'	38'	COLD PLANE 2", LEVEL WITH 1/2" TYPE IVS AND PAVE WITH 1-1/2" TYPE IVS
	2.55	3.171	12'	38'	COLD PLANE 2", LEVEL WITH 1/2" TYPE IVS AND PAVE WITH 1-1/2" TYPE IVS
	3.171	3.40	12'	34'	COLD PLANE 2", LEVEL WITH 1/2" TYPE IVS AND PAVE WITH 1-1/2" TYPE IVS
	3.40	3.541	12'	36'	COLD PLANE 2", LEVEL WITH 1/2" TYPE IVS AND PAVE WITH 1-1/2" TYPE IVS

SEE SHEET 14 FOR TRUCK CLIMBING LANE WIDTHS

SEE REVISED SHEET, PREVIOUS PAGE

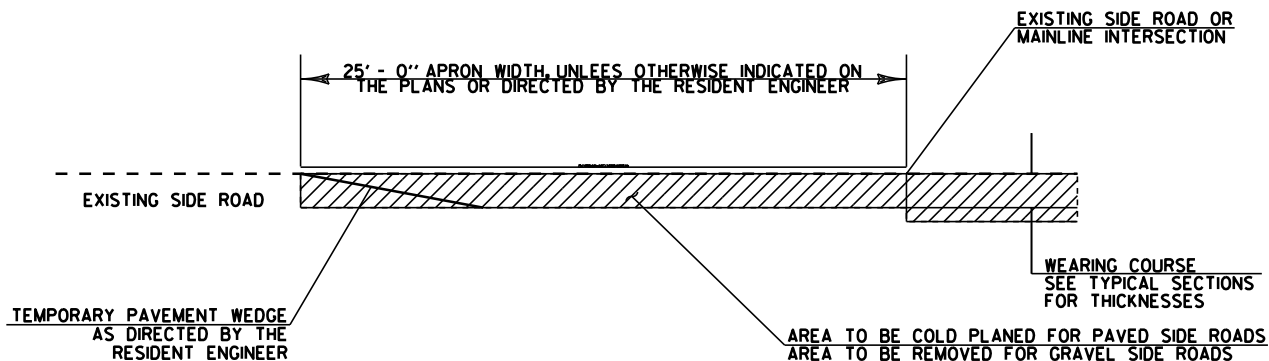

TRANSITION AREA FOR SIDE ROADS

SEE LAYOUT SHEETS FOR LOCATIONS OF ALL SIDE ROADS

TYPICAL SECTION SHEET #1	PROJECT NAME:	WOODFORD - SEARSBURG
	PROJECT NUMBER:	NH ST 2630 (I)
	FILE NAME: p06b228.dgn	PLOT DATE: 04-OCT-2011 12:47
	PROJECT LEADER: TED DOMEY	DRAWN BY: WILDER
DESIGNED BY: LSW	CHECKED BY: PAVT MGMT	
IPARM FILE NAME: 06b228typ1.i	SHEET 3 OF 24	