


TRUCK LANE MM 1.490-MM 3.210 SEARSBURG

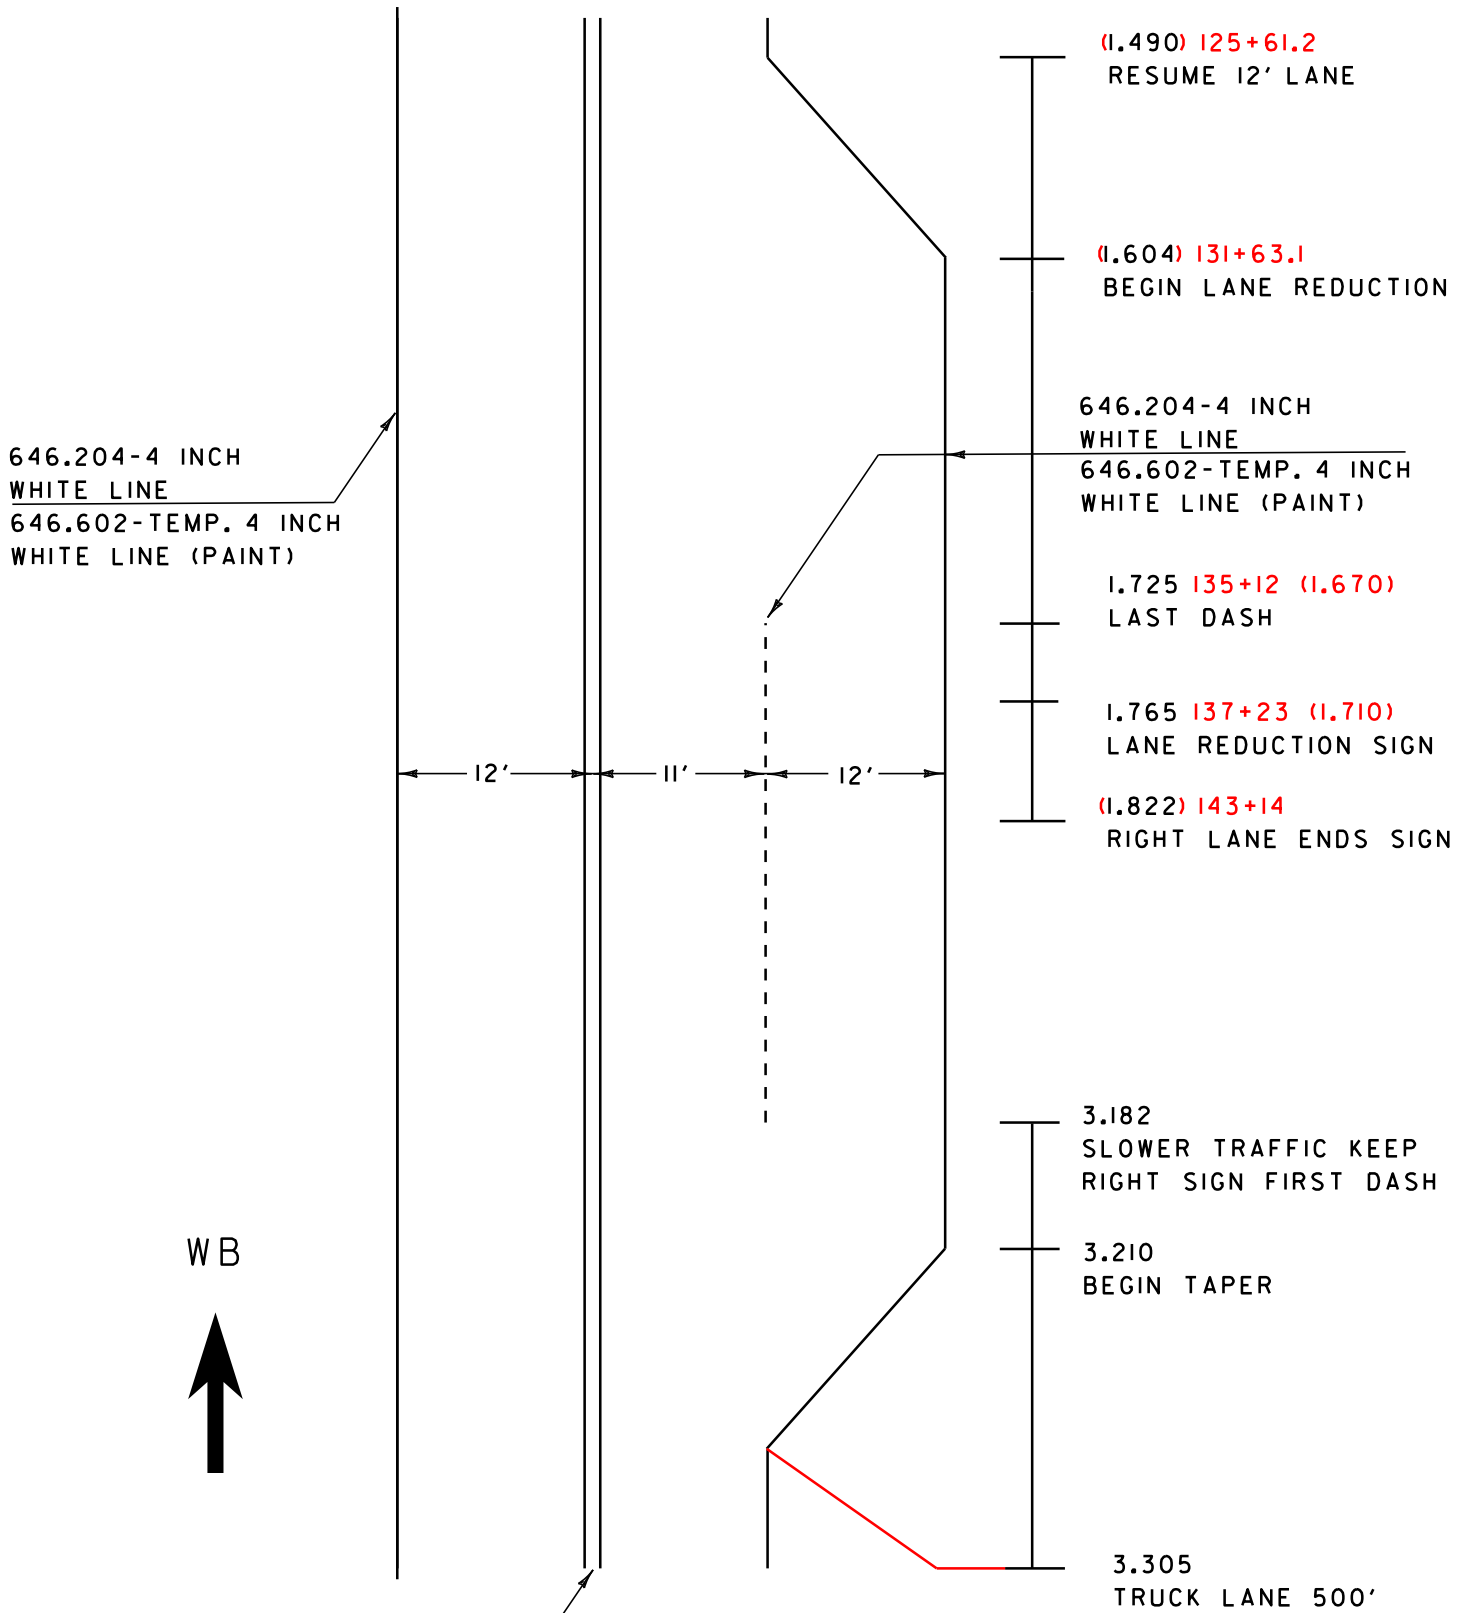

646.204-4 INCH
WHITE LINE
646.602-TEMP. 4 INCH
WHITE LINE (PAINT)

(1.490) 125+61.2
RESUME 12' LANE

(1.604) 131+63.1
BEGIN LANE REDUCTION

646.204-4 INCH
WHITE LINE
646.602-TEMP. 4 INCH
WHITE LINE (PAINT)

1.725 135+12 (1.670)
LAST DASH

1.765 137+23 (1.710)
LANE REDUCTION SIGN

(1.822) 143+14
RIGHT LANE ENDS SIGN

3.182
SLOWER TRAFFIC KEEP
RIGHT SIGN FIRST DASH

3.210
BEGIN TAPER

3.305
TRUCK LANE 500'



646.612-TEMP. 4 INCH
YELLOW LINE (PAINT)
646.214-4 INCH
YELLOW LINE

<p>LANE MARKING SHEET # 4</p>	PROJECT NAME:	WOODFORD - SEARSBURG
	PROJECT NUMBER:	NH ST 2630 (I)
	FILE NAME: p06b228.dgn	PLOT DATE: 04-OCT-2011 12:47
	PROJECT LEADER: TED DOMEY	DRAWN BY: WILDER
DESIGNED BY: WILDER	CHECKED BY: PAVT MGMT	
IPARM FILE NAME: 06b228lm4.i	SHEET 14 OF 24	