


TYPICAL BRIDGE SECTION

SCALE 1/2" = 1'-0"

\* BCP SHALL BE READ AS BITUMINOUS CONCRETE PAVEMENT AND SHALL BE PAID FOR UNDER PAY ITEM 900.68, 'SPECIAL PROVISION (BITUMINOUS CONCRETE PAVEMENT, SMALL QUANTITY)'.

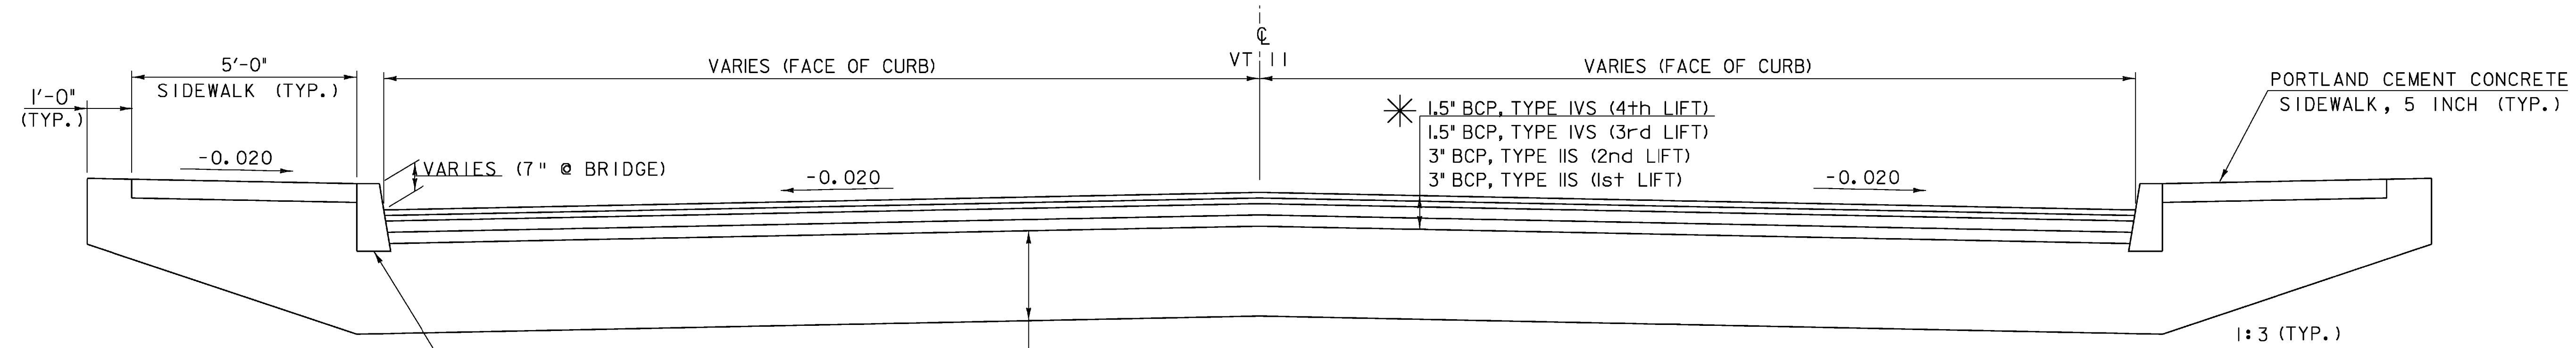

ROADWAY SECTION

SCALE 1/2" = 1'-0"

MATERIAL ITEM	TOLERANCE
PAVEMENT	± 1/4" TOTAL THICKNESS
BASE COURSE	± 1/2"
SUBBASE	± 1"

VOID  
SEE REVISED  
SHEET

PROJECT NAME:	SPRINGFIELD	PLOT DATE:	19-MAR-2009
PROJECT NUMBER:	BHF 016-2(14)	DRAWN BY:	C. MOONEY
FILE NAME:	s06J004sup.dgn	CHECKED BY:	D. PETERSON
PROJECT LEADER:	R. WHITCOMB	TYPICAL SHEET	SHEET 8 OF 72
DESIGNED BY:	C. CARLSON		