



VT III

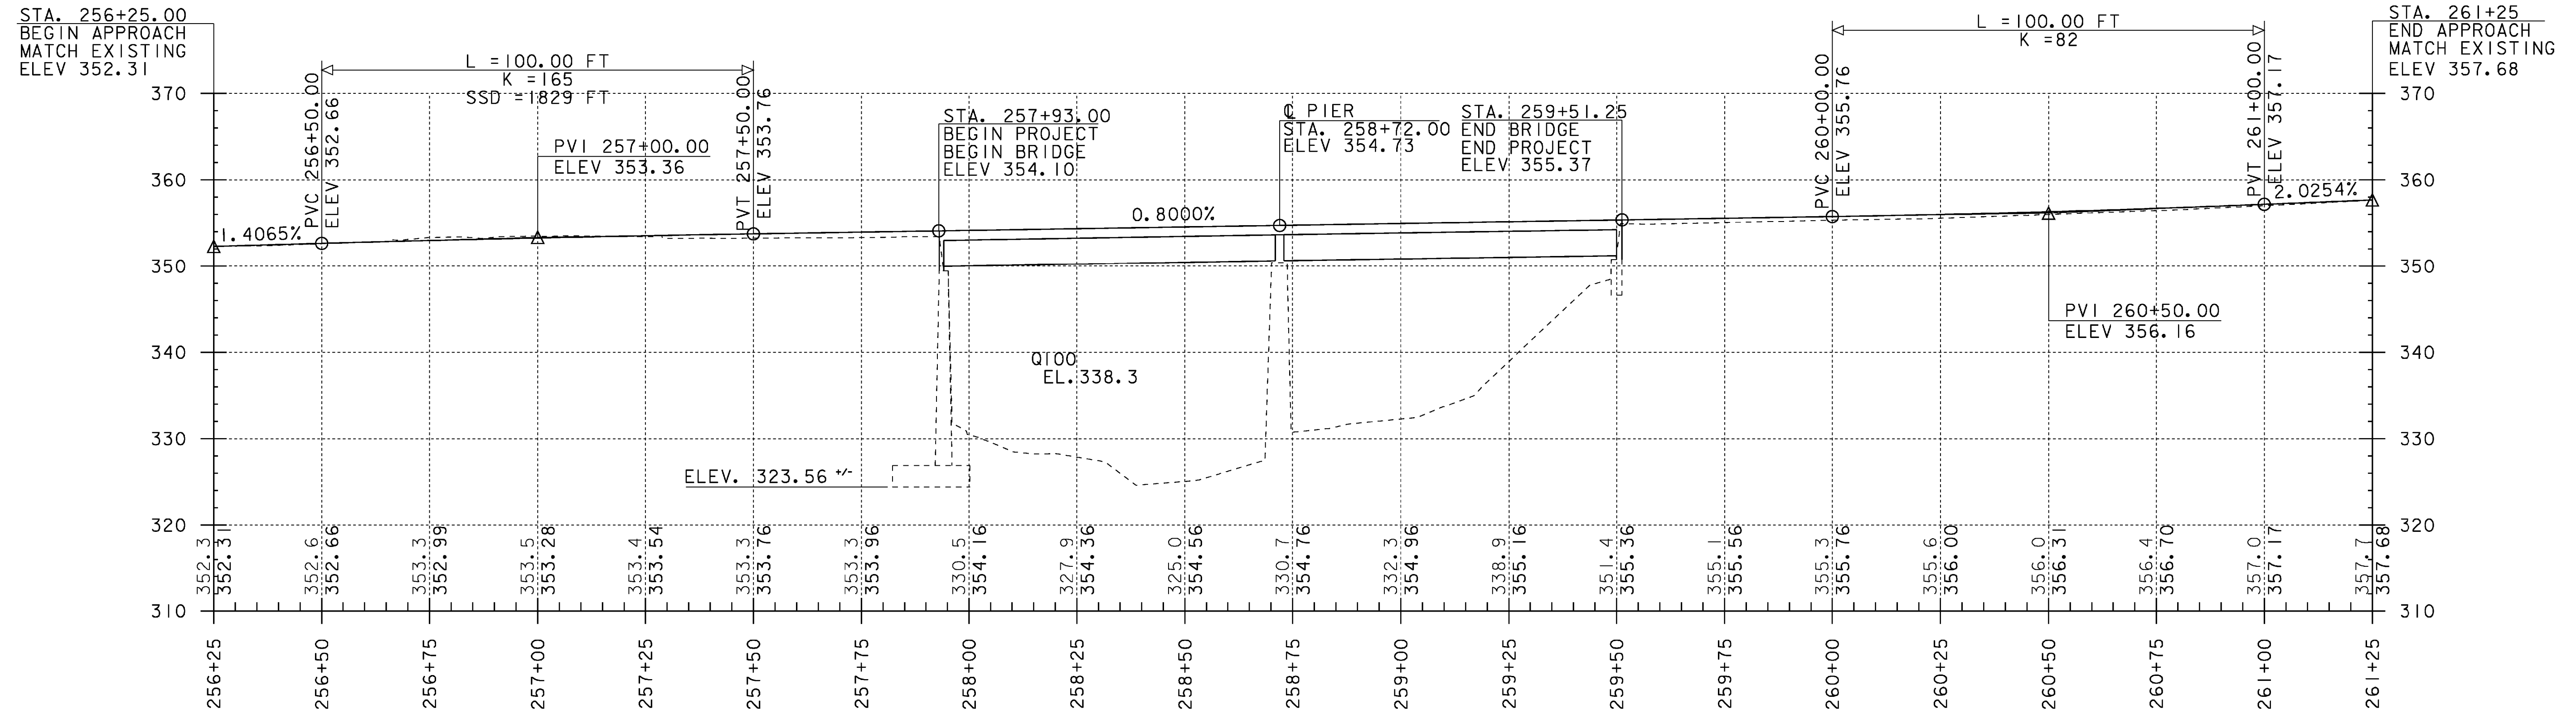

GRADES SHOWN TO THE NEAREST TENTH ARE OLD
 GROUND ALONG THE MAINLINE. GRADES SHOWN
 TO THE NEAREST HUNDREDTH ARE FINISH GRADE
 ALONG THE MAINLINE.

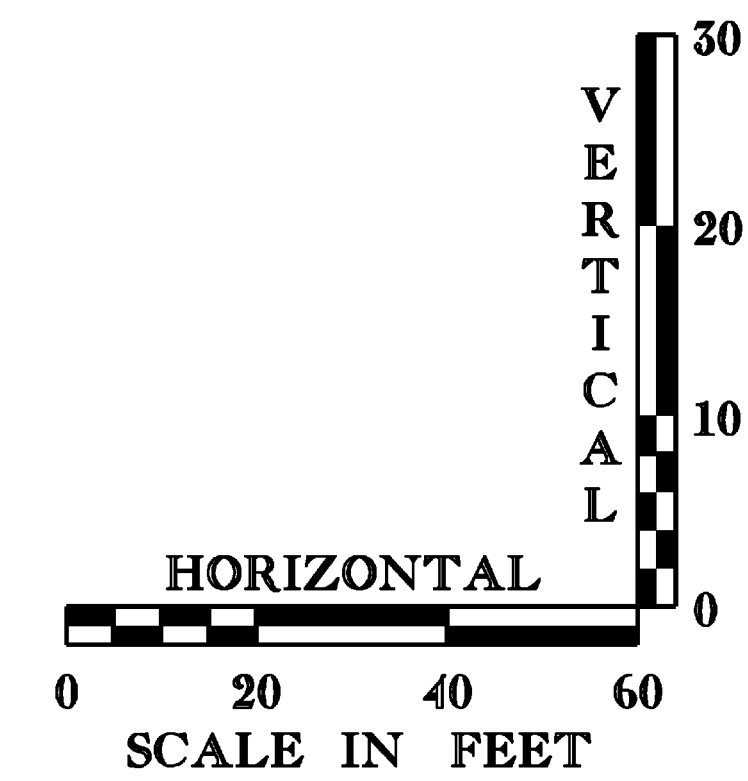

VOID
 SEE REVISED
 SHEET

PROJECT NAME: SPRINGFIELD	
PROJECT NUMBER: BHF 016-2(14)	
FILE NAME: 06j004/str/s06j004xsl.dgn	PLOT DATE: 04-MAR-2009
PROJECT LEADER: R. WHITCOMB	DRAWN BY: D. PETERSON
DESIGNED BY: D. PETERSON	CHECKED BY: C. CARLSON
PROFILE SHEET	SHEET II OF 72