



VT II TRUCK DETOUR I-91 EXIT 7

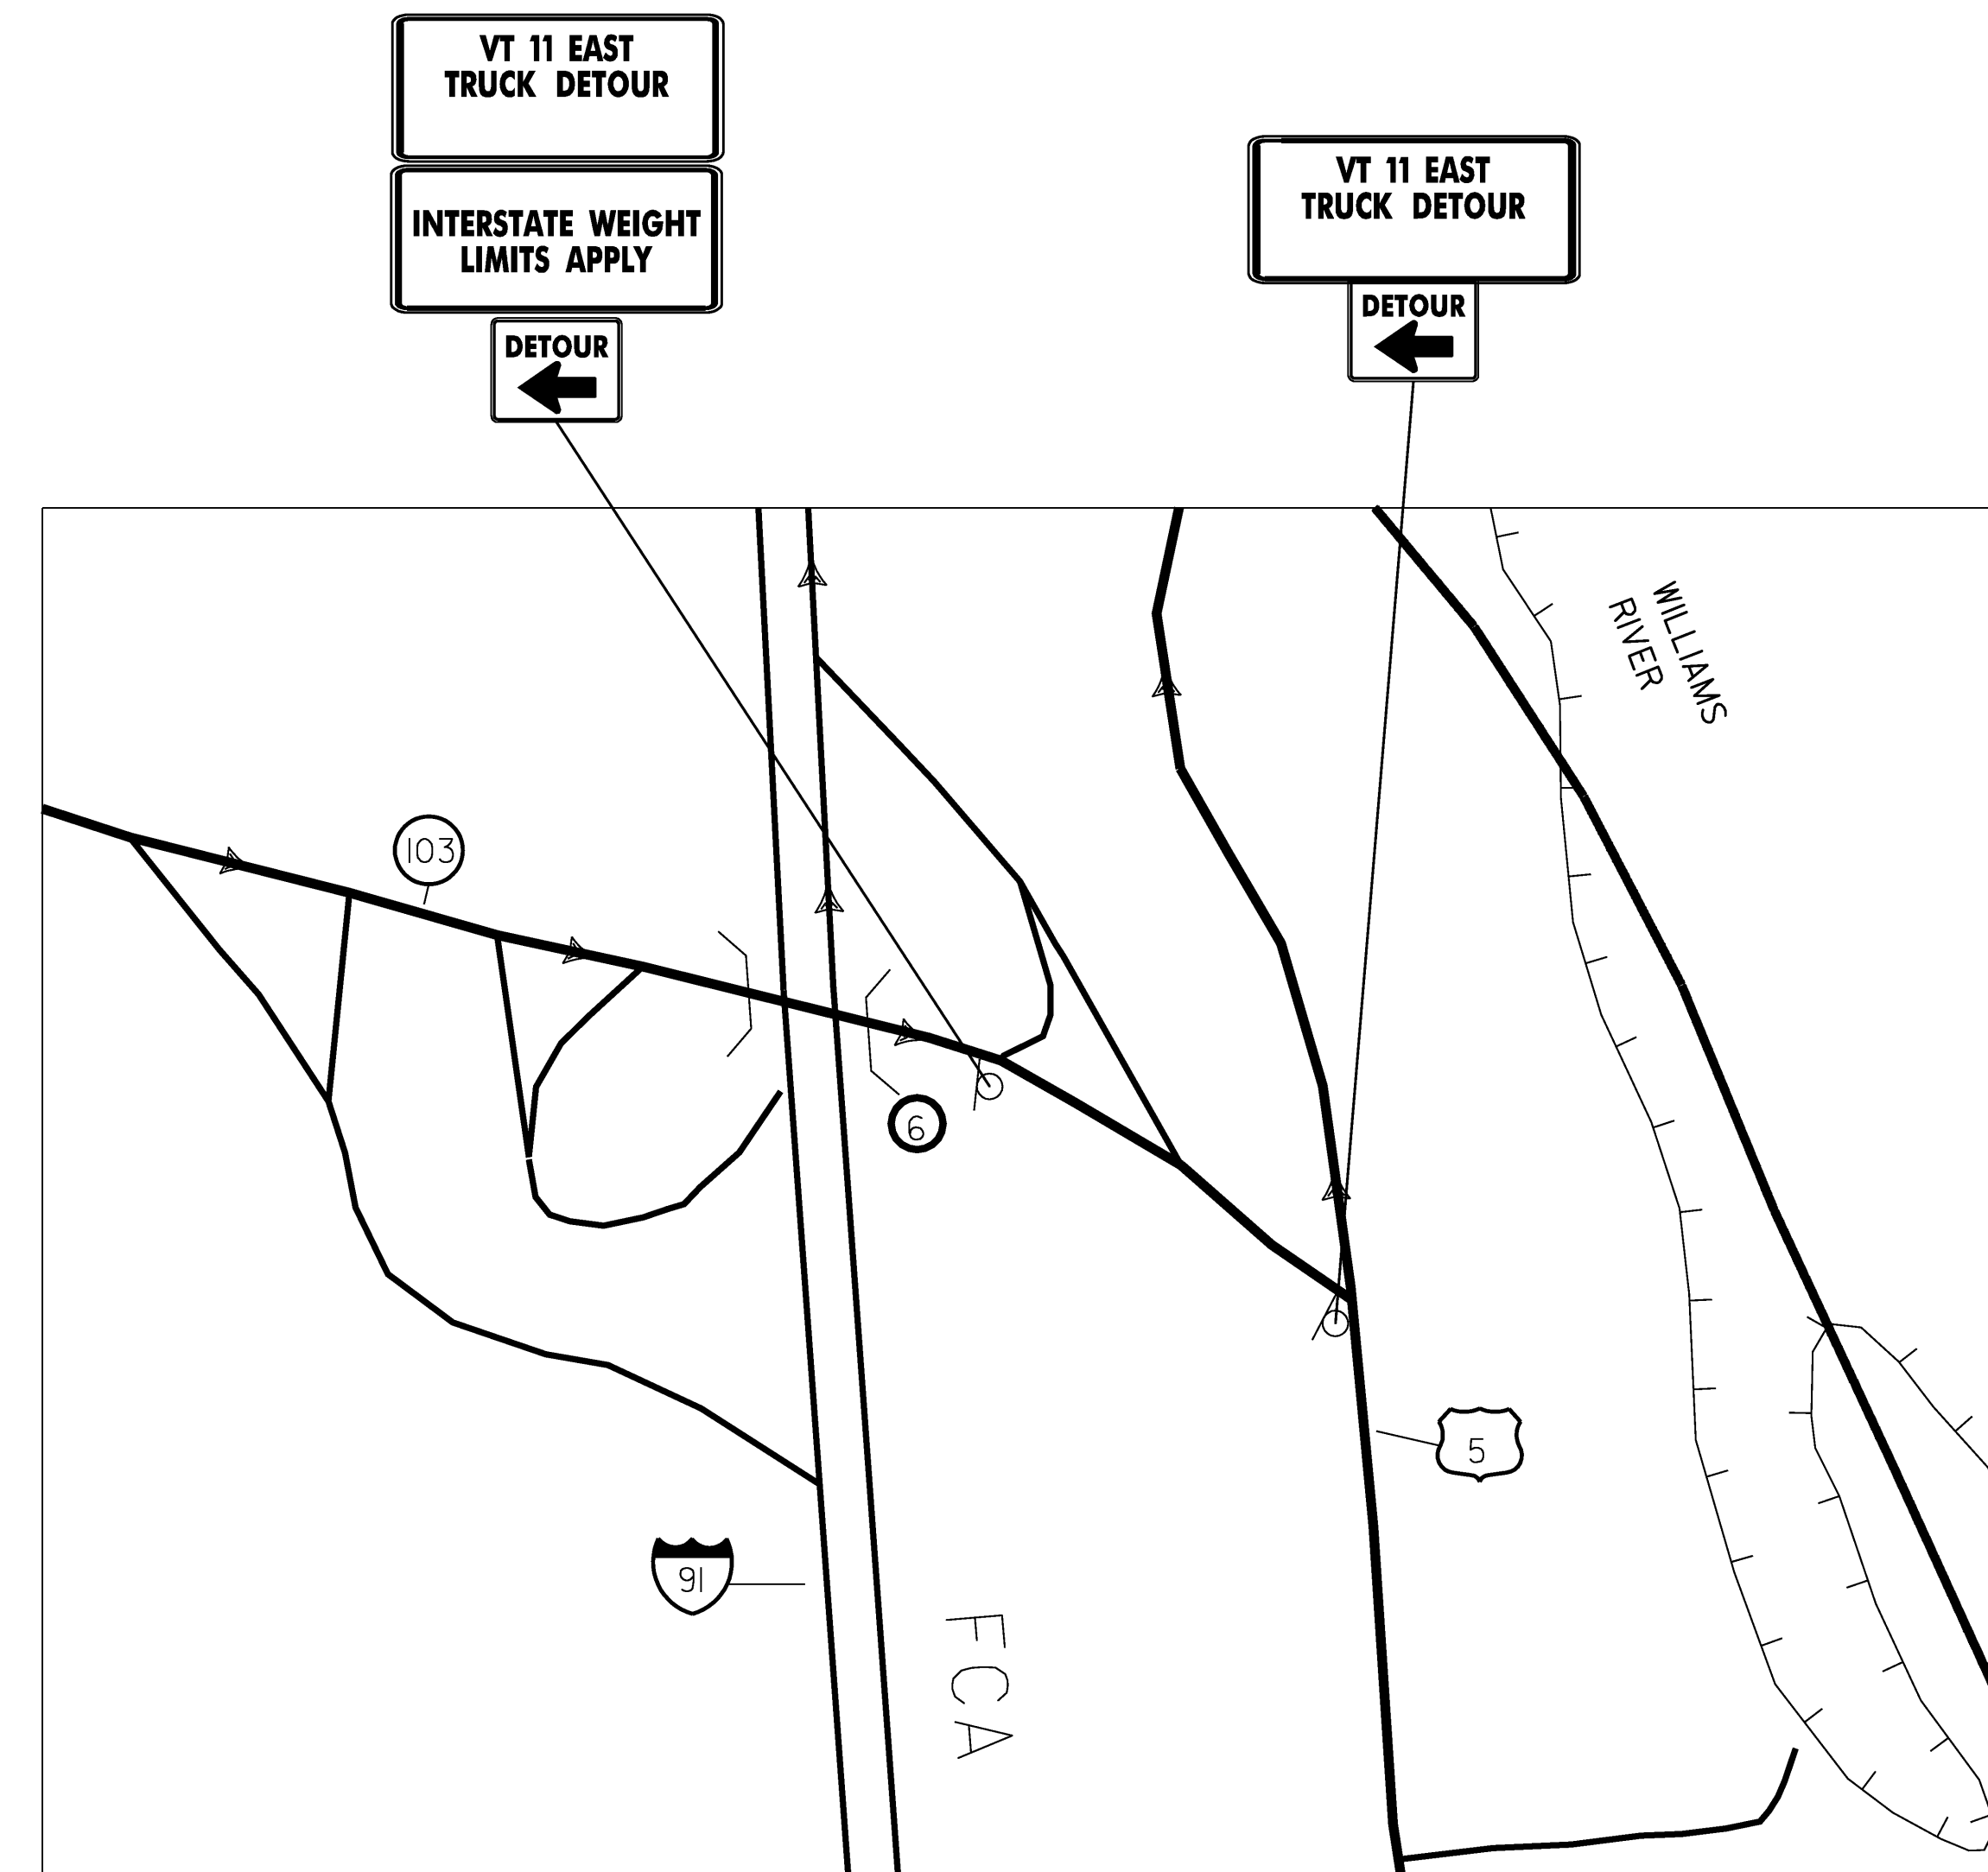

VT II TRUCK DETOUR I-91 EXIT 6

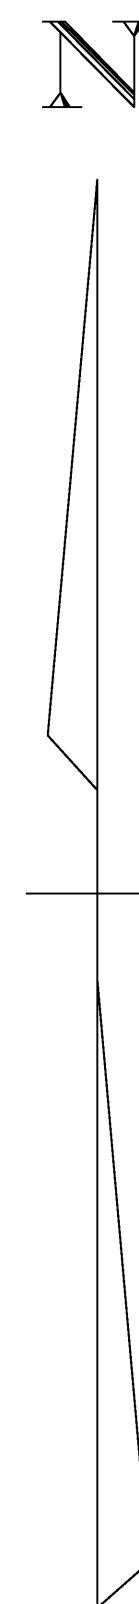

NTS

PROJECT NAME:	SPRINGFIELD	FILE NAME:	06J004/str/s06J004det.dgn	PLOT DATE:	04-MAR-2009
PROJECT NUMBER:	BHF 016-2 (14)	PROJECT LEADER:	R. WHITCOMB	DRAWN BY:	D. PETERSON
		DESIGNED BY:	D. PETERSON	CHECKED BY:	C. CARLSON
		TRAFFIC CONTROL SHEET	4	SHEET	15 OF 72