


PLAN

SCALE 1" = 10'-0"
10 0 10

STREET LIGHTING LEGEND

- ① LIGHT POLE NUMBER
- ⊕ LIGHT BASE
- ≡≡≡ PROPOSED LIGHTING CONDUIT
- ⊞ JUNCTION BOX

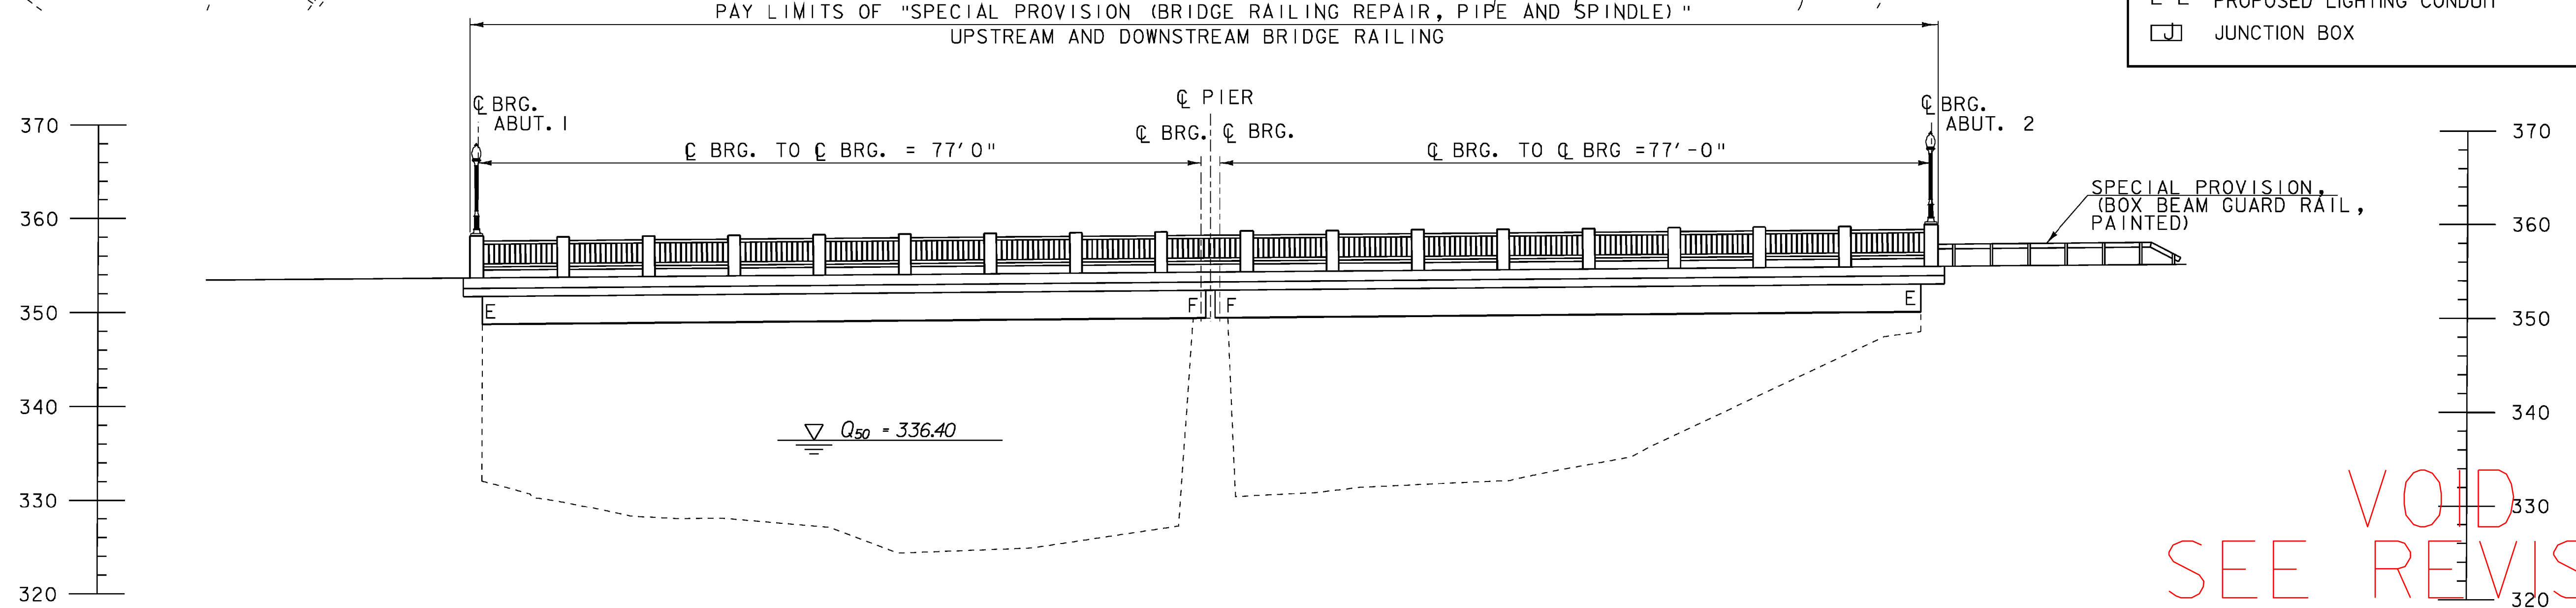

ELEVATION

SCALE 1" = 10'-0"
10 0 10

VOID
SEE REVISED
SHEET

PROJECT NAME: SPRINGFIELD	PLOT DATE: 19-MAR-2009
PROJECT NUMBER: BHF 016-2(14)	DRAWN BY: D. PETERSON
FILE NAME: 06J004/str/s06J004pe.dgn	CHECKED BY: C. CARLSON
PROJECT LEADER: R. WHITCOMB	SHEET 23 OF 72
DESIGNED BY: D. PETERSON	
PLAN AND ELEVATION SHEET	