


PLAN

SCALE 1" = 10'-0"

STREET LIGHTING LEGEND

- ① LIGHT POLE NUMBER
- ⊕ LIGHT BASE
- ≡≡≡ PROPOSED LIGHTING CONDUIT
- JUNCTION BOX

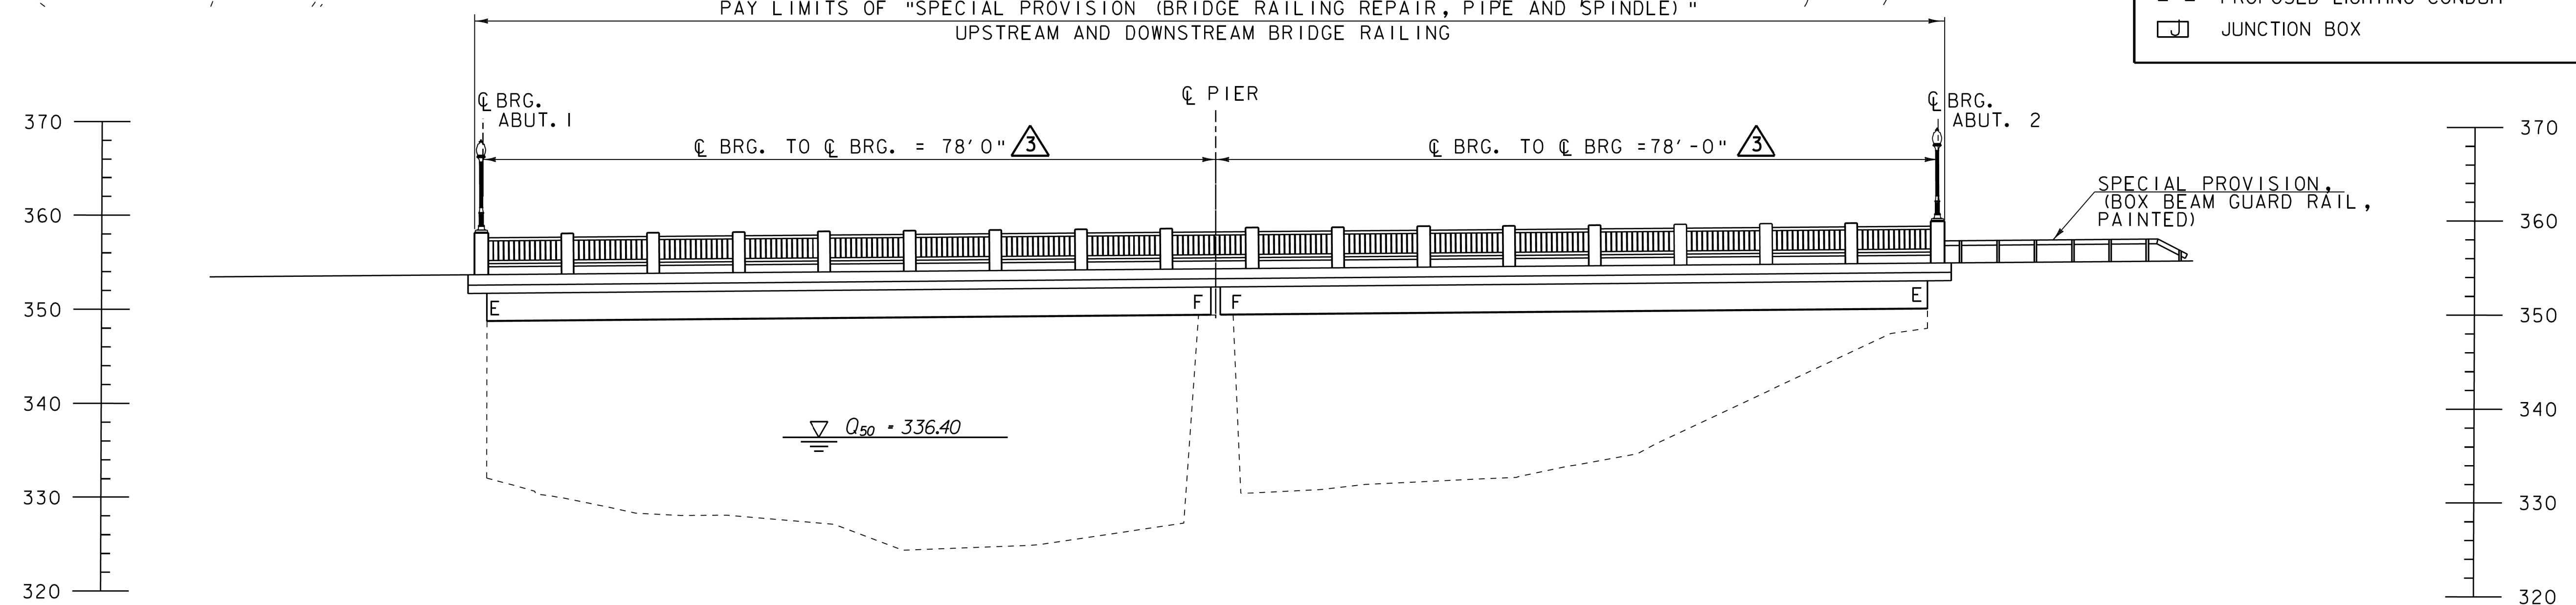

ELEVATION

SCALE 1" = 10'-0"

REV.	BY	DATE	DESCRIPTION
3	LBB	5/26/09	CHANGED FINISH GRADE AND LENGTH TO CL BEARING

PROJECT NAME: SPRINGFIELD
 PROJECT NUMBER: BHF 016-2(14)
 FILE NAME: 06j004/str/s06j004pe.dgn
 PROJECT LEADER: R. WHITCOMB
 DESIGNED BY: D. PETERSON
 PLAN AND ELEVATION SHEET

PLOT DATE: 10-AUG-2011
 DRAWN BY: D. PETERSON
 CHECKED BY: C. CARLSON
 SHEET 23 OF 72